

WELL PLUGGING RECORD

Give All Information Completely
Make Required Affidavit
Mail or Deliver Report to:
Conservation Division
State Corporation Commission
800 Bittling Building
Wichita, Kansas

Ellis County. Sec. 21 Twp. 11 Rge. 17 (E) (W)

Location as "NE/CNW $\frac{1}{4}$ SW $\frac{1}{4}$ " or footage from lines NW NE NE

Lease Owner The El Dorado Refining Company

Lease Name BEMIS Well No. 5

Office Address Box 551, El Dorado, Kansas

Character of Well (completed as Oil, Gas or Dry Hole) Oil

Date well completed 9-19- 19 36

Application for plugging filed 9-12- 19 49

Application for plugging approved 9-13- 19 49


Plugging commenced 9-28- 19 49

Plugging completed 10-4- 19 49

Reason for abandonment of well or producing formation Non Commercial

If a producing well is abandoned, date of last production 1-22- 19 49

Was permission obtained from the Conservation Division or its agents before plugging was commenced? Yes

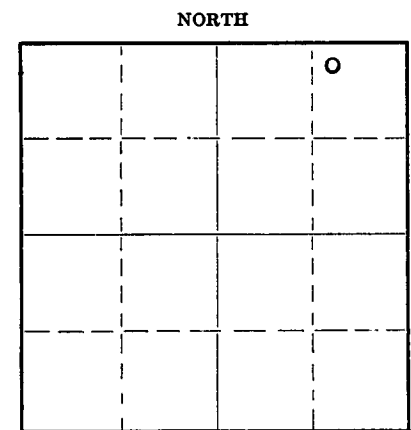

Locate well correctly on above Section Plat

Name of Conservation Agent who supervised plugging of this well Eldon Petty

Producing formation Arbuckle Depth to top Bottom Total Depth of Well 3344 Feet

Show depth and thickness of all water, oil and gas formations.

OIL, GAS OR WATER RECORDS

CASING RECORD

Formation	Content	From	To	Size	Put In	Pulled Out
				10"	1042'	0000
				7"	3339'	1069'-6"

Describe in detail the manner in which the well was plugged, indicating where the mud fluid was placed and the method or methods used in introducing it into the hole. If cement or other plugs were used, state the character of same and depth placed, from.....feet to.....feet for each plug set.

Mudded hole from bottom up to 250'.
Set bridge and run 25 sacks of cement at 250'. Then mudded up to 30'. Run 20 sacks of cement to cap.

RECORDED
INDEXED
OCT 14 1949
STATE CORPORATION COMMISSION
KANSAS

(If additional description is necessary, use BACK of this sheet)

Correspondence regarding this well should be addressed to The El Dorado Refining Company
Address Box 551, El Dorado, Kansas

STATE OF KANSAS, COUNTY OF RUSSELL, ss.
Levi B. Sherman (employee of owner) or (owner or operator) of the above-described well,

being first duly sworn on oath, says: That I have knowledge of the facts, statements, and matters herein contained and the log of the above-described well as filed and that the same are true and correct. So help me God.

(Signature) Levi B. Sherman
Box 209 - Russell, Kansas
(Address)

SUBSCRIBED AND SWORN to before me this 13 day of October, 19 49

My commission expires October 13, 1952

Verrel J. Brack Notary Public.


FILED 21 11 176
BOOK PAGE 113 LINE 37

WINKLER-KOCH ENGINEERING CO.
 Bemis No. 5

Sec. 21 - Twp. 11 - Rge. 17W
 NW NE NE

Total Depth 3344'
 Comma. 8-27-36 Comp. 9-19-36
 Shot or Treated
 Contractor: Corbett-Barbour Drlg. Co.
 Issued: 10-24-36

County: Ellis

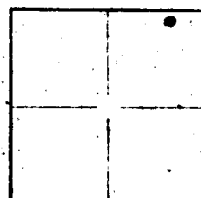

CASING
 15" 98'
 10" 1042'
 7" 3339'

Elevation: 1830'

Production: Pot. 55 BPH

Figures Indicate Bottom of Formations

Shale and shells	350'
Clay	385
Shale	400
Lime	430
Sand and Shale	727
Shale	775
Red Rock	855
Shale	991
Shale and Shells	1032'
Anhydrite	1085
Red beds	1250
Shale	1405
Salt	1560
Shale and shells	1740
Lime	1775
Broken Lime	1850
Shale and lime	1950
Lime	2030
Shale and lime	2060
Broken Lime	2120
Shale and shells	2240
Broken lime	2400
Shale	2637
Broken lime	2710
Shale	2770
Broken lime	2773
Lime	2870
Broken Lime	2890
Topeka lime	2975
Shale	2985
Lime	3014
Broken lime	3137
Shale	3180
Kansas City Lime	3312
Conglomerate	3339
Siliceous Lime	3344

RECORDED

SEP 15 1949

STATE OF KANSAS
 GEOLOGICAL SURVEY
 KANSAS

3339-3343' Hole filled up 2500'
 3343-3344' " " " 3000'

COPY

COPY

PLUGGING
 THE RESULT 11-17-36
 BOOK PAGE 113 LINE 37