


Get All Information Completely
Make Required Affidavit.
Mail or Deliver Report to:
Conservation Division
State Corporation Commission
800 Bittling Building
Wichita, Kansas

15-051-19348-0000
WELL PLUGGING RECORD

NORTH

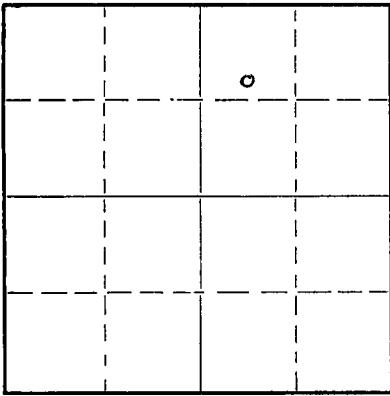

Locate well correctly on above
Section Plat

ELLIS County, Sec. 21 Twp. 11 Rge. 17 (E) W. (W)
Location as "NE/CNW $\frac{1}{4}$ SW $\frac{1}{4}$ " or footage from lines C-SL - N- $\frac{1}{4}$ - NE
Lease Owner The El Dorado Refining Company
Lease Name BEMIS Well No. 1 - SWD
Office Address Box 551 - El Dorado, Kansas
Character of Well (completed as Oil, Gas or Dry Hole) SWD
Date well completed May 3, 19 37
Application for plugging filed July 13, 19 50
Application for plugging approved July 17, 19 50
Plugging commenced July 17, 19 50
Plugging completed July 18, 19 50
Reason for abandonment of well or producing formation
In-put on great pressure
If a producing well is abandoned, date of last production None 19
Was permission obtained from the Conservation Division or its agents before plugging was commenced? Yes

Name of Conservation Agent who supervised plugging of this well Eldon Petty
Producing formation Depth to top Bottom Total Depth of Well 716 Feet
Show depth and thickness of all water, oil and gas formations.

OIL, GAS OR WATER RECORDS

CASING RECORD

Formation	Content	From	To	Size	Put In	Pulled Out
				10"	32'	None
				8-5/8"	280'	None
				7"	571'	None

Describe in detail the manner in which the well was plugged, indicating where the mud fluid was placed and the method or methods used in introducing it into the hole. If cement or other plugs were used, state the character of same and depth placed, from.....feet to.....feet for each plug set.

Pumped into formation - mixed and pumped 300 sacks of cement into casing - did not chase with water - casing plugged with cement to 11' of surface - went in under no pressure and had no vacuum - hole in 7" at 280' and cement circulated between 8" and 7" to surface.

07-24-50

(If additional description is necessary, use BACK of this sheet)

Correspondence regarding this well should be addressed to The El Dorado Refining Co.
Address Box 551, El Dorado, Kansas


STATE OF KANSAS, COUNTY OF RUSSELL, ss.
Levi B. Sherman (employee of owner) or (owner operator) of the above-described well,
being first duly sworn on oath, says: That I have knowledge of the facts, statements, and matters herein contained and the log of the above-described well as filed and that the same are true and correct. So help me God.

(Signature) Levi B. Sherman
Box 209 - Russell, Kansas
(Address)

SUBSCRIBED AND SWORN to before me this 22 day of July, 19 50

My commission expires 10-13-50

Veruel J. Brack
Notary Public.

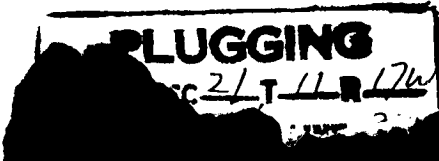

THE EL DORADO REFINING COMPANY

EL DORADO, KANSAS

BEMIS SALT WATER DISPOSAL WELL NO. 1

NE $\frac{1}{4}$ 21-11-17W, Ellis County, Kansas

Commenced April 14, 1937 - Completed May 3, 1937

Location: C-SL - N/ $\frac{1}{2}$ - NE $\frac{1}{4}$

1-	8	Surface
8-	25	Brown Shale
25-	30	quick sand
30-	170	blue shale
170-	175	water sand
175-	218	Gray shale
218-	224	Brown shale
224-	275	Water sand
275-	280	Gray shale
280-	291	red bed
291-	296	white sand
296-	316	red bed
316-	323	Sandy shale
323-	331	red bed
331-	336	Blue shale
336-	382	Grat shale
382-	391	sand
391-	393	lime
393-	436	white sand
436-	453	Sand
453-	493	iron & sand
493-	515	Lime
515-	520	blue shale
520-	526	Sand
526-	528	shale
528-	532	Sand & shale
532-	542	Shale
542-	550	Iron & Sand
550-	569	blue shale
569-	572	lime
572-	714	sand XXXXXX
714-	716	red rock
716		Total Depth

10" Casing driven to 32'

8" casing set & cemented at 280'

7" casing set & cemented at 571'

571-716' open hole - sand

716' Total Depth