

STATE OF KANSAS
STATE CORPORATION COMMISSION


Give All Information Completely
Make Required Affidavit
Mail or Deliver Report to:
Conservation Division
State Corporation Commission
211 No. Broadway
Wichita, Kansas

WELL PLUGGING RECORD

Ellis County, Sec. 21 Twp. 11S Rge. 17W (E) W (W)

Location as "NE/CNW/SW" or footage from lines NW 1/4 NE 1/4 SW 1/4
Lease Owner Ryan Consolidated Petroleum Corporation
Lease Name Frank Bemis "C" Well No. 6 "C"
Office Address 3400 Republic National Bank Building, Dallas 1, Texas
Character of Well (completed as Oil, Gas or Dry Hole) Oil Well
Date well completed July 9 19 40
Application for plugging filed Approximately (phoned) May 4 19 62
Application for plugging approved No date on letter 19
Plugging commenced May 9 19 62
Plugging completed May 9 19 62
Reason for abandonment of well or producing formation collapsed casing

NORTH

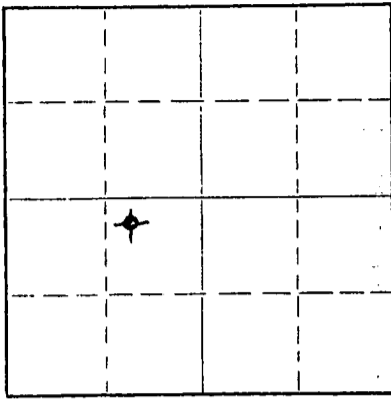

Locate well correctly on above Section Plat

If a producing well is abandoned, date of last production unknown 19
Was permission obtained from the Conservation Division or its agents before plugging was commenced? Yes

Name of Conservation Agent who supervised plugging of this well Mr. Eldon Petty
Producing formation Siliceous Lime Depth to top 3404 Bottom 3409 Total Depth of Well 3409 Feet
Show depth and thickness of all water, oil and gas formations.

OIL, GAS OR WATER RECORDS

CASING RECORD

FORMATION	CONTENT	FROM	TO	SIZE	PUT IN	PULLED OUT
Siliceous Lime	Oil	3404	3409	4 1/2	3401	None

Describe in detail the manner in which the well was plugged, indicating where the mud fluid was placed and the method or methods used in introducing it into the hole. If cement or other plugs were used, state the character of same and depth placed, from _____ feet to _____ feet for each plug set. See below
Ran tubing to 2420 (collapse) - pressured to 1000 - 1400# - pumped 34 sax mud followed with 75 sax cement

Log on reverse side

Plugging approved by Mr. Petty

RECEIVED
DATE
05-28-62
CONSERVATION DIVISION

(If additional description is necessary, use BACK of this sheet)

Name of Plugging Contractor Ryan crew using Halliburton pump trucks.
Address _____

STATE OF TEXAS, COUNTY OF Dallas, ss.
Walter Ziegler (employee of owner) or (owner or operator) of the above-described well, being first duly sworn on oath, says: That I have knowledge of the facts, statements, and matters herein contained and the log of the above-described well as filed and that the same are true and correct. So help me God.

(Signature) Walter Ziegler
3400 Republic Bank Bldg., Dallas 1, Texas
(Address)

SUBSCRIBED AND SWORN TO before me this 25th day of May, 19 62

My commission expires June 1, 1963

Polly Ray
POLLY RAY Notary Public.

WELL LOG

BEMIS 6 "C"

NW 1/4 NE 1/4 SW 1/4 Sec 21 - 11S - 17W
Ellis County, Kansas

<u>Formation</u>	<u>TO</u>	<u>FROM</u>
Collar	0	10
Shale	10	75
Shale, shells and red bed	75	430
Sand	430	560
Iron	560	595
Iron and shale	595	630
Shale	630	750
Dakota sand and strks of iron	750	840
Red bed	840	1080
Red rock	1080	1117
Anhydrite Lime	1117	1152
Broken lime and shale	1152	1313
Red rock	1313	1388
Blue shale and shells	1388	1455
Shale and lime shells	1455	1500
Salt, shale and lime shells	1500	1680
Lime and shale	1680	1727
Lime and shale, brkn	1727	1730
Lime, hard	1730	1817
Lime	1817	2080
Shale	2080	2095
Lime	2095	2140
Lime, hard	2140	2176
Lime	2176	2230
Shale	2230	2240
Lime	2240	2275
Sandy lime	2275	2290
Lime	2290	2435
Lime, hard	2435	2494
Lime	2494	2570
Shale	2570	2600
Lime	2600	2643
Blue shale	2643	2665
Grey lime	2665	2710
Dark grey lime	2710	2748
Lime, brkn	2748	2825
Grey lime	2825	2924
Shale and lime, brkn	2924	2938
Grey lime	2938	2969
Lime	2969	3011
Lime, lt grey	3011	3020
Shale, blue	3020	3033
Lime, grey	3033	3063
Lime	3063	3080
Lime, lorous	3080	3100
Lime, grey	3100	3168
Lime grey	3168	3182
Lime	3182	3218
Lime, white	3218	3241
Lime, grey	3241	3283
Lime	3283	3292
Lime, white	3292	3334
Lime, lt grey	3334	3384
Lime	3384	3390
Simpson shale	3390	3400
Simpson Sand	3400	3402
Simpson Dolomite	3402	3404
Arbuckle dolomite	3404	3409