


STATE OF KANSAS
STATE CORPORATION COMMISSION

WELL PLUGGING RECORD

Give All Information Completely
Make Required Affidavit
Mail or Deliver Report to:
Conservation Division
State Corporation Commission
800 Bittling Building
Wichita, Kansas

NORTH

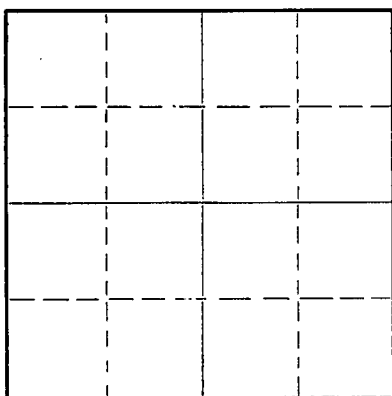

Locate well correctly on above
Section Plat

Ellis County. Sec. 21 Twp. 11 Rge. (E) 17 (W)
Location as "NE/CNW $\frac{1}{4}$ SW $\frac{1}{4}$ " or footage from lines 990'N 990'W of SE Corner
Lease Owner Cities Service Oil Co.
Lease Name Bemis Well No. 6
Office Address Bartlesville, Oklahoma
Character of Well (completed as Oil, Gas or Dry Hole) Oil
Date well completed June 26 19 37
Application for plugging filed 4-11 19 49
Application for plugging approved 4-12 19 49
Plugging commenced 4-14 19 49
Plugging completed 4-19 19 49
Reason for abandonment of well or producing formation Unprofitable

If a producing well is abandoned, date of last production January 19 46
Was permission obtained from the Conservation Division or its agents before plugging was commenced? Yes

Name of Conservation Agent who supervised plugging of this well *Mr. R. C. Cooper*
Producing formation Arbuckle Depth to top 3373' Bottom Total Depth of Well 3376' Feet
Show depth and thickness of all water, oil and gas formations.

OIL, GAS OR WATER RECORDS

CASING RECORD

Formation	Content	From	To	Size	Put In	Pulled Out
Arbuckle Lime	Water			15 $\frac{1}{2}$ "	107	None
				10"	1099	None
				7"	3370	7782'

Describe in detail the manner in which the well was plugged, indicating where the mud fluid was placed and the method or methods used in introducing it into the hole. If cement or other plugs were used, state the character of same and depth placed, from.....feet to.....feet for each plug set.

Filled with mud from total depth to 2720', dumped 10 sacks cement mud to 250'.
Set bridge dumped 20 sacks cement, mud to 20', dumped 10 sacks cement, mud and dirt to surface.

RWD
03-19-49

(If additional description is necessary, use BACK of this sheet)

Correspondence regarding this well should be addressed to Mr. R. C. Cooper
Address Box 751 Great Bend, Kansas

STATE OF Kansas, COUNTY OF Russell, ss.
Mr. James Porter (employee of owner) or (owner/producer) of the above-described well,

being first duly sworn on oath, says: That I have knowledge of the facts, statements, and matters herein contained and the log of the above-described well as filed and that the same are true and correct. So help me God.

(Signature) *James Porter*

Box 553, Russell, Kansas (Address)

SUBSCRIBED AND SWORN to before me this 7th day of May 1949

My commission expires 3-17-1951

Notary Public.

22-5133-s 9-48-10M

PLUGGING
FILE SEC 21 T 11 R 17
BOOK PAGE 89 LINE 14

Company Cities Service Oil Co. Well No. 6 Farm Bemis
 Location 990' North and 992' West of SE Corner Sec. 21 T 11 R. 17W
 Elevation..... County Ellis State Kansas
 Drlg.Comm. May 29, 1937 Contractor J. E. Mabee
 Drlg.Comp. June 27, 1937 Acid None
 T. D. 3376' Initial Prod. 1708 oil, no water, 24 hrs.

CASING RECORD:

15-1/2" @ 100' cem. 80 sx
 10" @ 1099' cem. 352 sx
 7" OD @ 3370' cem. 250 sx

Top Siliceous Lime 3370' SLM
 Penetration 6'
 Total Depth 3376'

FORMATION RECORD:

sand & clay	40
shale & sand	100
shale & shells	1070
shale, shells & red beds	1100
anhydrite	1120
shale, shells	1180
shale	1309
shale & lime	1600
shale & broken lime	1715
shale & lime	1805
lime	1922
shale & lime	2022
lime	2145
broken lime	2230
lime	2510
shale & shells	2615
lime	2673
lime & shale	2822
lime	3232
lime & shale	3263
lime	3305
lime & shale	3367
sandy shale	3370
sand (dl)	3373
siliceous lime	3374
lime	3376 T. D.

SIM Corr. 3374 - 3371

Fillup: 200' 20 mins.
 900' 40 mins.
 2300' 1 1/2 hrs.
 2800' 3 hrs.
 2900' 4 hrs.

PLUGGING
 FILE SEC. 21 T. 11 R. 17W
 PAGE 89 OF 14

03-31-49