


Give All Information, Completely
Make Required, Affidavit
Mail or Deliver Report to:
Conservation Division
State Corporation Commission
800 Bittling Building
Wichita, Kansas

WELL PLUGGING RECORD

NORTH

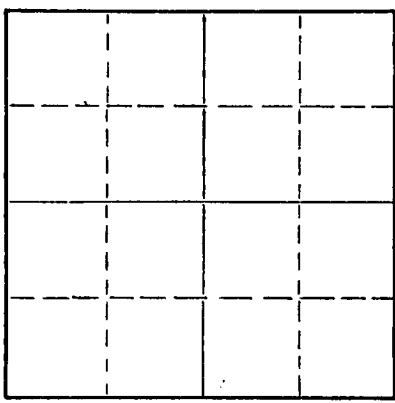

Locate well correctly on above
Section Plat

Ellis County. Sec. 21 Twp. 11 Rge. (E) 17 (W)
Location as "NE/CNWxSWx" or footage from lines SW SW Se
Lease Owner Cities Service Oil Co.
Lease Name Bemis Well No. 10
Office Address Bartlesville, Oklahoma
Character of Well (completed as Oil, Gas or Dry Hole) oil
Date well completed 9/1/37 19
Application for plugging filed 3/1/54 19
Application for plugging approved 3/2/54 19
Plugging commenced 3/5/54 19
Plugging completed 3/6/54 19
Reason for abandonment of well or producing formation non-commercial

If a producing well is abandoned, date of last production 2/17/54 19
Was permission obtained from the Conservation Division or its agents before plugging was commenced? yes

Name of Conservation Agent who supervised plugging of this well Mr. Eldon Petty
Producing formation Arbuckle Depth to top 3376' Bottom _____ Total Depth of Well 3384 Feet
Show depth and thickness of all water, oil and gas formations.

OIL, GAS OR WATER RECORDS

CASING RECORD

FORMATION	CONTENT	FROM	TO	SIZE	PUT IN	PULLED OUT
				15 1/2"	106'	0
				10-3/4"	1111'	0
				7"	3376'	2160'
				4 1/2"	3452'	3021'

Describe in detail the manner in which the well was plugged, indicating where the mud fluid was placed and the method or methods used in introducing it into the hole. If cement or other plugs were used, state the character of same and depth placed, from _____ feet to _____ feet for each plug set.

Mud to 310', 10' of rock, 25 sx. cement to 260', mud to 30',
rock to 20', cement to surface with 10 sx. cement.

RCW
03-16-54

(If additional description is necessary, use BACK of this sheet)

Name of Plugging Contractor Schull Casing Pulling Co.
Address Great Bend, Kansas

STATE OF KANSAS, COUNTY OF BARTON
James Porter (employee of owner) or owner or operator of the above-described well, being first duly sworn on oath, says: That I have knowledge of the facts, statements, and matters herein contained and the log of the above-described well as filed and that the same are true and correct. So help me God.

(Signature) James Porter
Box 553, Russell, Kansas
(Address)

SUBSCRIBED AND SWORN TO before me this 15th day of March, 1954
W. D. Smith
Notary Public.

My commission expires 3-12-1955

PLUGGING
FILE SEC 21 T 11 R 17 W
BOOK PAGE 12 LINE 2

WELL RECORD

Company Cities Service Oil Co. Well No. 10 Farm Denis
 Location 330' North and 330' East of 1/4 Corner Sec. 21 T. 11 R. 17W
 Elevation 1886 County Ellis State Kansas
 Drlg. Comm. December 18, 1947 Contractor Signal Oilfield Service
 Drlg. Comp. December 27, 1947 Acid 250 gals. 3426-36 (1-3-48)
250 gals. 3402-10 (2-7-48); 250 gals. 3373-80 (1-9-48)
 T. D. 3454; P.B.T.D. 3418 Initial Prod Pumped 16 oil, 184 water, 24 hours (1-23-48)
3390

DEVELOPING RECORD

CASING RECORD:

15-1/2" @ 106' cen. 85 sx cement
 10-3/4" @ 1111' cen. 460 sx cement
 7" @ 3374' cen. 265 sx cement
 4-1/2" @ 3452' cen. 50 sx cement

FORMATION RECORD:

Old Total Depth 3384
 line 3384-3428
 line, sandy 3443
 line 3448
 sandy line 3452
3452 = 3454 S. L. M.

Top Artuckle 3376'
 Penetration 78'
 Total Depth 3454'

Drilled cement to 3439 S. L. M.

Perf. 20 shots 3426-30
 Perf. 11 shots 3433-36

1-3-48 Acidized 250 gals.
 Sumbed 5 bbls. water per hr.
 with good show oil.

Set Lane-walls plug at 3418 S. L. M.

Perf. 32 shots 3402-10

1-7-48 Acidized 250 gals. 3402-10
 Sumbed 5 gals. fluid per hr.

Perf. 20 shots 3373-80
 150' fluid in 1 hour
 275' fluid in 2 hours
 400' fluid in 3 hours
 750' fluid in 12 hours

P.B. with Calseal 3418-3390