

WELL PLUGGING RECORD

OR


FORMATION PLUGGING RECORD

Strike out upper line when reporting plugging of formations.

STATE OF KANSAS CORPORATION COMMISSION

Give All Information Completely Make Required Affidavit Mail or Deliver Report to: Conservation Division State Corporation Commission 800 Bitting Building Wichita, Kansas

Ellis County. Sec. 21 Twp. 11 Rge. (E) 17 (W) Location as "NE 1/4 NW 1/4 SW 1/4" or footage from lines SW NW SE Lease Owner Cities Service Oil Company Lease Name Bemis Well No. 14 Office Address Bartlesville, Oklahoma Character of Well (completed as Oil, Gas or Dry Hole) Oil Date well completed 1 - 11 1938 Application for plugging filed 6 - 1 1946 Application for plugging approved 6 - 1 1946 Plugging commenced 6 - 3 1946 Plugging completed 6 - 6 1946 Reason for abandonment of well or producing formation Unprofitable

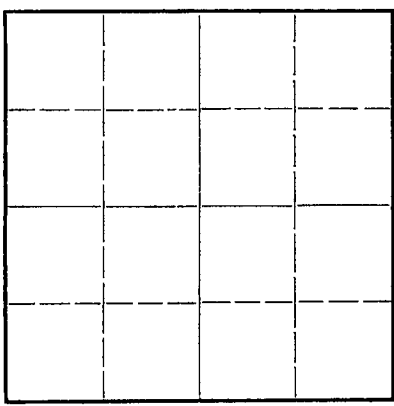

Locate well correctly on above Section Plat

If a producing well is abandoned, date of last production April 1946 Was permission obtained from the Conservation Division or its agents before plugging was commenced? Yes

Name of Conservation Agent who supervised plugging of this well Mr. Herb Kerr Producing formation Arbuckle lime Depth to top 3369 Bottom Total Depth of Well 3382 Feet Show depth and thickness of all water, oil and gas formations.

OIL, GAS OR WATER RECORDS

CASING RECORD

Table with 7 columns: Formation, Content, From, To, Size, Put In, Pulled Out. Row 1: Arbuckle lime, Water, 15 1/2, 101', None. Row 2: 10 3/4, 1096', None. Row 3: 7", 3369, 2198'

Describe in detail the manner in which the well was plugged, indicating where the mud fluid was placed and the method or methods used in introducing it into the hold. If cement or other plugs were used, state the character of same and depth placed, from feet to feet for each plug set.

Dumped 6 sacks cement at 3300' mud to 250' - dumped 20 sacks cement mud to 15' - dumped 10 sacks cement mud and dirt to surface.

Handwritten: 21 11 17W 55 1

(If additional description is necessary, use BACK of this sheet)

Correspondence regarding this well should be addressed to Mr. R. C. Hauber Address Cities Service Oil Company Great Bend, Kansas

Handwritten: RCUO 06-18-46

STATE OF Kansas, COUNTY OF Barton, ss. Mr. James Porter (employee of owner) or (owner or operator) of well, being first duly sworn on oath, says: That I have knowledge of the facts, statements, and matters herein contained above-described well as filed and that the same are true and correct. So help me God.

(Signature)

Handwritten signature: James Porter

Box 553 Russell, Kansas (Address)

SUBSCRIBED AND SWORN to before me this 15th day of June 1946

My commission expires mch 17, 1947

Notary Public.

WELL RECORD

Company Cities Service Oil Co. Well No. 14 Farm Bemis

Location 996.4' South and 330' East of Center Sec. 21 T. 11 R. 17W

Elevation _____ County Ellis State Kansas

Drig. Comm. December 11, 1937 Contractor J. E. Mabee

Drig. Comp. January 9, 1938 Acid None

T. D. 3382' Initial Prod. 2092 oil, 0 water, 24 hours, natural

CASING RECORD:

15-1/2" 101' cem. 100 sacks
10-3/4" 1096' cem. 515 sacks
7" 3369' cem. 265 sacks

FORMATION RECORD:

surface 25
shale 103
shale & shells 370
shale, shells & sand 755
shale & shells 1070
lime 1080
anhydrite 1110
anhydrite, shale 1197
shale & shells 1480
salt 1617
shale & shells 1741
lime & shale 2066
broken lime 2139
lime & shale 2195
shale & shells 2300
shale & lime 2363
lime 2410
lime & shale 2455
shale 2541
shale & shells 2720
shale 2803
shale & shells 2852
lime 3078
lime & shale 3227
lime 3281
lime & shale 3334
shale 3355
shale 3369
sand & shale 3371
lime 3372
lime (cored) (very S.S.O.) 3373
SIM Corr. 3373 = 3371
lime (S.O.) 3382 T. D.

Top Simpson Shale 3350'
Top Sand 3366 1/2'
Top Siliceous 3369'
Penetration 13'
Total Depth 3382'

Pay 3371-3373'
Some Pay 3378-3382'

Fillup: 2300' 1 hr.
2700' 1 1/4 hrs.
2750' 2 1/4 hrs.

SYFO: 1500' 1°
2000' 0°
2500' 1/2°
3000' 0°

21 11 17W
55 1

