


STATE OF KANSAS
STATE CORPORATION COMMISSION

15:05/ 21421-00-00
WELL PLUGGING RECORD

Give All Information Completely
Make Required Affidavit
Mail or Deliver Report to
Conservation Division
State Corporation Comm.
245 North Water
Wichita, KS 67202

Ellis County. Sec. 12 Twp. 13 Rge. 18 XE/W
Location as "NE/CNW $\frac{1}{4}$ SW $\frac{1}{4}$ " or footage from lines _____
SW NW NE
Lease Owner Dreiling Oil, Inc.
Lease Name Ubert Well No. A-#2
Office Address Rt. #1, Victoria, KS 67671
Character of Well (Completed as Oil, Gas or Dry Hole) _____

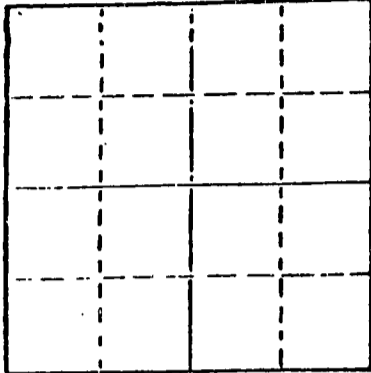

Locate well correctly on above
Section Plot

Dry Hole
Date Well completed 11-26 1977
Application for plugging filed 12-5 1977
Application for plugging approved 12-5 1977
Plugging commenced 12-7 1977
Plugging completed 12-7 1977
Reason for abandonment of well or producing formation _____

If a producing well is abandoned, date of last production 19 _____

Was permission obtained from the Conservation Division or its agents before plugging was commenced? yes _____

Name of Conservation Agent who supervised plugging of this well Leo Massey
Producing formation _____ Depth to top _____ Bottom _____ Total Depth of Well 3647'
Show depth and thickness of all water, oil and gas formations.

OIL, GAS OR WATER RECORDS

CASING RECORD

FORMATION	CONTENT	FROM	TO	SIZE	PUT IN	PULLED OUT
Surface Pipe				8 5/8"	175'	0'
Casing				4 1/2"	3,513'	2,905'

Describe in detail the manner in which the well was plugged, indicating where the mud fluid was placed and the method or methods used in introducing it into the hold. If cement or other plugs were used, state the character of same and depth placed, from _____ feet to _____ feet for each plug set.

RECEIVED
STATE CORPORATION COMMISSION

Plug set @ 3,100'. Placed down in order on top of plug:
2 sacks cement, 20 sacks gel, 70 sacks cement, 5 sacks gel,
1 sack hulls, and 50 sacks of cement. Max. Pressure 600#.
Shut in Pressure 500#.

DEC - 9 1977

CONSERVATION DIVISION
Wichita, Kansas

(If additional description is necessary, use BACK of this sheet)

Name of Plugging Contractor Dreiling Oil, Inc.

STATE OF KANSAS COUNTY OF ELLIS, ss.

I, Joseph A. Hess, Sec. Treas. of Drlg. Contrc. (employee of owner) or (owner or operator) of the above-described well, being first duly sworn on oath, says: That I have knowledge of the facts, statements, and matters herein contained and the log of the above-described well as filed and that the same are true and correct. So help me God.

(Signature)

JOSEPH A. HESS, HAYS, KS 67601

(Address)

SUBSCRIBED AND SWORN TO before me this 8th day of December, 1977

Cecilia Basgall
Cecilia Basgall Notary Public.

My commission expires November 17, 1980.

CECILIA BASGALL
NOTARY PUBLIC
Ellis County, Kansas

DREILING OIL, INC.

Victoria, Kansas 67671

Dreiling Oil, Inc.

WELL LOG

Company	Rt. #1 Victoria, KS 67671		Sec. 12	Twpl. 3	Ang. 18
Farm	Ubert	No. A #2	Location	SW NW NE	
Total Depth	3,647'		County	Ellis	
Comm.	11-21-77	Comp. 11-26-77	Elevation:	2094	K. B.
Contractor	Dreiling Oil, Inc. Rt. #1 Victoria, KS 67671			2091	D. F.
				2089	G. R.

Casing Record
175' - 8 5/8"
3513' - 4 1/2"

Cement Record
125 sacks cement
cemented w/125 sacks
common cement

Production:

Figures Indicate Bottom of Formations

0'	179'	Post Rock & Shale
179'	425'	Shale
425'	1325'	Shale-Sand-Red Bed
1325'	1371'	Anhydrite
1371'	1740'	Shale
1740'	3387'	Shale & Lime
3387'	3647'	Lime
3647'	T.D.	

STATE OF KANSAS)
)ss
COUNTY OF ELLIS)

I, Joseph A. Hess, Secretary Treasurer of Dreiling Oil, Inc., upon oath states that the above and foregoing is a true and correct copy from the Daily Drilling Report from the Ubert A-#2.


JOSEPH A. HESS

Subscribed and sworn to before me this 5th day of December, 1977


Cecilia Basgall Notary Public

My appointment expires: November 17, 1980.

**CECILIA BASGALL
NOTARY PUBLIC
Ellis County, Kansas**

RECEIVED
STATE CORPORATION COMMISSION

DEC 06 1977.

CONSERVATION DIVISION
Wichita, Kansas