


STATE OF KANSAS  
STATE CORPORATION COMMISSION

15-05121537-00-00  
WELL PLUGGING RECORD

Give All Information Completely  
Make Required Affidavit  
Mail or Deliver Report to  
Conservation Division  
State Corporation Comm.  
245 North Water  
Wichita, KS 67202

Ellis County, Sec. 12 Twp. 13 Rge. 18 ESW  
Location as "NE/CNW $\frac{1}{4}$ SW $\frac{1}{4}$ " or footage from lines  
150' West of C-N/2N/2 NE/4  
Lease Owner Dreiling Oil, Inc.  
Lease Name Ubert Well No. A-#4  
Office Address Rt. #1, Victoria, KS 67671  
Character of Well (Completed as Oil, Gas or Dry Hole)

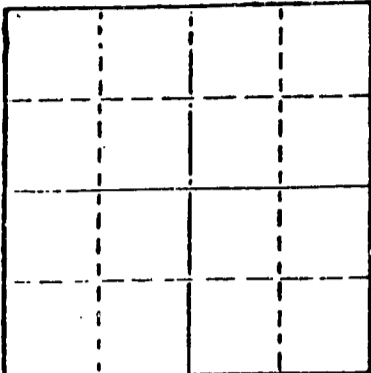

Locate well correctly on above  
Section Plot

Dry Hole  
Date Well completed 8-11 19 78  
Application for plugging filed 8-11 19 78  
Application for plugging approved 8-11 19 78  
Plugging commenced 8-11 19 78  
Plugging completed 8-11 19 78  
Reason for abandonment of well or producing formation  
Dry Hole

If a producing well is abandoned, date of last production  
19

Was permission obtained from the Conservation Division or  
its agents before plugging was commenced? yes

Name of Conservation Agent who supervised plugging of this well Leo Massey  
Producing formation Depth to top Bottom Total Depth of Well 3665'  
Show depth and thickness of all water, oil and gas formations.

OIL, GAS OR WATER RECORDS

CASING RECORD

FORMATION	CONTENT	FROM	TO	SIZE	PUT IN	PULLED OUT
Surface Pipe				8 5/8"	167'	0'

Describe in detail the manner in which the well was plugged, indicating where the mud fluid was placed and the method or methods used in introducing it into the hold. If cement or other plugs were used, state the character of same and depth placed, from feet to feet for each plug set.

- 1st plug was set @ 500' w/50 sacks cement
- 2nd plug was set @ 125' w/25 sacks cement
- 3rd plug was set @ 40' w/10 sacks cement

STATE CORPORATION COMMISSION

AUG 21 1978  
08-21-78

CONSERVATION DIVISION  
Wichita, Kansas

(If additional description is necessary, use BACK of this sheet)

Name of Plugging Contractor Dreiling Oil, Inc.

STATE OF KANSAS COUNTY OF ELLIS, ss.

I, Joseph A. Hess, Sec. Treas. of Drlg. Contrc. (employee of owner) or (owner or operator) of the above-described well, being first duly sworn on oath, says: That I have knowledge of the facts, statements, and matters herein contained and the log of the above-described well as filed and that the same are true and correct. So help me God.

(Signature)

JOSEPH A. HESS, HAYS, KS 67601  
(Address)

SUBSCRIBED AND SWORN TO before me this 17th day of August, 19 78

Cecilia Basgall  
Cecilia Basgall Notary Public.

My commission expires November 17, 1980.

CECILIA BASGALL  
NOTARY PUBLIC  
Ellis County, Kansas

# DREILING OIL, INC.

Victoria, Kansas 67671

1503775 11-1-78

Dreiling Oil, Inc. Rt. #1 Victoria, KS 67671	<b>WELL LOG</b>	Sec. 12	Twp. 13	Rng. 18
Farm Ubert No. A-#4		Location	150' West of C-N/2 - N/2-NE/4	
Total Depth 3,665'		County	Ellis	
Comm. 8-5-78 Comp. 8-11-78		Elevation:	2092	K. B.
Contractor Dreiling Oil, Inc. Rt. #1 Victoria, KS 67671			2089	D. F.
			2087	G. R.

Casing Record	Cement Record	Production:
127' - 8 5/8"	85 sacks cement	D & A

### Figures Indicate Bottom of Formations

0'	890'	Shale
890'	1328'	Shale & Sand
1328'	1376'	Anhydrite
1376'	1803'	Shale
1803'	2550'	Shale & Lime
2550'	2745'	Lime & Shale
2745'	3135'	Shale & Lime
3135'	3665'	Lime
3665'	T.D.	

STATE OF KANSAS)  
  )ss  
COUNTY OF ELLIS)

I, Joseph A. Hess, Secretary Treasurer of Dreiling Oil, Inc., upon oath states that the above and foregoing is a true and correct copy from the Daily Drilling Report from the Ubert A #4.

  
JOSEPH A. HESS

Subscribed and sworn to before me this 17th day of August, 1978.

  
Cecilia Basgall Notary Public

My appointment expires: November 17, 1980.

CECILIA BASGALL  
NOTARY PUBLIC  
Ellis County, Kansas

307  
AUG 21 1978  
ELLIS COUNTY, KANSAS