

15:05/3040/00:00
WELL PLUGGING RECORD

Give All Information Completely
Make Required Affidavit
Mail or Deliver Report to:
Conservation Division
State Corporation Commission
212 No. Market
Wichita, Kansas

Rice County. Sec. 12 Twp. 13S Rge. (E) 18(W)

Location as "NE/CNW&SW&" or footage from lines NW NW SE

Lease Owner Messman-Rinehart Oil Co.

Lease Name Kansas State University Well No. 1

Office Address 1432 Wichita Plaza - Wichita, Kansas

Character of Well (completed as Oil, Gas or Dry Hole) dry

Date well completed 12-7 19 66

Application for plugging filed 12-7- 19 66

Application for plugging approved 12-7 19 66


Plugging commenced 5:30 12-7- 19 66

Plugging completed 10:30 12-7 19 66

Reason for abandonment of well or producing formation dry

If a producing well is abandoned, date of last production none 19

Was permission obtained from the Conservation Division or its agents before plugging was commenced? yes

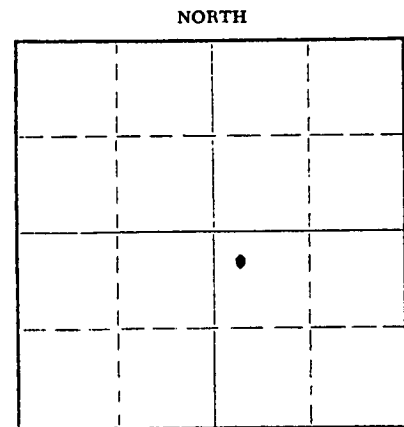

Locate well correctly on above Section Plat

Name of Conservation Agent who supervised plugging of this well Leo Massey - Hays, Kansas

Producing formation none Depth to top Bottom Total Depth of Well 3497 Feet

Show depth and thickness of all water, oil and gas formations.

OIL, GAS OR WATER RECORDS

CASING RECORD

FORMATION	CONTENT	FROM	TO	SIZE	PUT IN	PULLED OUT
Soil Rock & Sahle		0	262	8 5/8"	262	0

Describe in detail the manner in which the well was plugged, indicating where the mud fluid was placed and the method or methods used in introducing it into the hole. If cement or other plugs were used, state the character of same and depth placed, from feet to feet for each plug set.

Filled hole to plug - Set plug at 540' Cemented with 25 sacks set plug at 240' with 20 sacks hole filled to 40' with 8 sacks and 2 sacks in rat hole. Plug with pump truck

DEC 12 1966
12-12-66
CONSERVATION DIVISION
WICHITA, KANSAS

(If additional description is necessary, use BACK of this sheet)
Name of Plugging Contractor B & B Drilling Inc.
Address 548 Petroleum Building - Wichita, Kansas

STATE OF Kansas, COUNTY OF Sedgwick, ss.

Bill Lahar (employee of owner) or (owner or operator) of the above-described well, being first duly sworn on oath, says: That I have knowledge of the facts, statements, and matters herein contained and the log of the above-described well as filed and that the same are true and correct. So help me God.

(Signature) Bill Lahar

548 Petroleum Building - Wichita, Kansas
(Address)

SUBSCRIBED AND SWORN to before me this 9th day of December, 19 66

Alma A. Neeses
Notary Public.

My commission expires May 31, 1970

B & B DRILLING, INC.

548 Petroleum Building

Wichita, Kansas 67202

December 9, 1966

15-051-30401-00-00
DRILLERS LCG

Re: Kansas State University
NW NW SE
Section 12-13S-18W
Ellis County, Kansas

COMPANY: Messman-Rinehart Oil Co.
CONTRACTOR: B & B Drilling Inc.
TOTAL DEPTH: 3497'
COMMENCED: December 1, 1966
COMPLETED: December 7, 1966

0	180	Soil - Rock & Shale
180	262	Shale & Shells
262	709	Shale & Shells
709	1275	Shale
1275	1383	Shale
1385	1425	Anhydrite
1425	1420	Shale
1420	1910	Shale
1910	2050	Shale
2050	2105	Lime
2105	2170	Lime & Shale
2170	2370	Shale & Lime
2370	2535	Shale & Lime
2535	2688	Lime & Shale
2688	3080	Shale & Lime
3082	3390	Lime
3390	3480	Lime
3480	2497	Lime
3497		Total Depth D & A

RECORDED
INDEXED
DEC 12 1966
CONSERVATION DIVISION
STATE OF KANSAS

We certify the above and foregoing to be true and correct copy of the log on the Kansas State University, located in Ellis County, Kansas

B & B DRILLING INC.

Bill Zahar President

Alma A. Neises Notary Public

Subscribed and sworn to before me this 9th day of December, 1966. My commission expires May 31, 1970