

STATE OF KANSAS
STATE CORPORATION COMMISSION


15-051-00031-00-00
WELL PLUGGING RECORD

All Information Completely
Make Required Affidavit
Mail or Deliver Report to:
Conservation Division
State Corporation Commission
800 Bitting Building
Wichita, Kansas

Ellis

County. Sec. 12 Twp. 13S Rge. 18W (E) (W)

NORTH

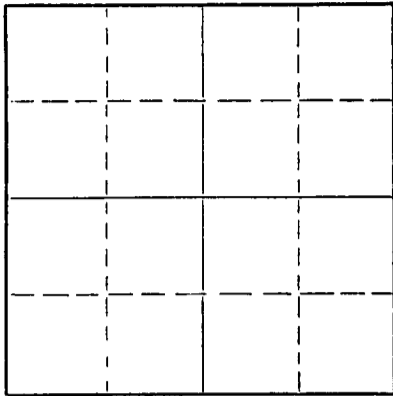

Locate well correctly on above
Section Plat

Location as "NE/CNW/SW" or footage from lines NW NW NW
Lease Owner M & L OIL COMPANY
Lease Name Drilling Well No. 1
Office Address 211 Brown Building, Wichita, Kansas
Character of Well (completed as Oil, Gas or Dry Hole) Dry Hole
Date well completed July 14th 19 52
Application for plugging filed July 14th 19 52
Application for plugging approved July 14th 19 52
Plugging commenced July 14th 19 52
Plugging completed July 14th 19 52
Reason for abandonment of well or producing formation Dry Hole

If a producing well is abandoned, date of last production _____ 19 _____

Was permission obtained from the Conservation Division or its agents before plugging was commenced? yes

Name of Conservation Agent who supervised plugging of this well Eldon Petty
Producing formation _____ Depth to top _____ Bottom _____ Total Depth of Well 3721 Feet
Show depth and thickness of all water, oil and gas formations.

OIL, GAS OR WATER RECORDS

CASING RECORD

FORMATION	CONTENT	FROM	TO	SIZE	PUT IN	PULLED OUT
				<u>8 5/8"</u>	<u>232'</u>	<u>cemented</u>

Describe in detail the manner in which the well was plugged, indicating where the mud fluid was placed and the method or methods used in introducing it into the hole. If cement or other plugs were used, state the character of same and depth placed, from _____ feet to _____ feet for each plug set.

Heavy mud from 3721', total depth, to 220'. Set solid plug and 20 sacks of cement through drill pipe. Heavy mud to 40' and 10 sacks of cement to top.

(If additional description is necessary, use BACK of this sheet)

Name of Plugging Contractor M & L OIL COMPANY
Address 211 Brown Building, Wichita, Kansas

STATE OF Kansas, COUNTY OF Sedgwick, ss.
Leuter Greenberg (employee of owner) or (owner or operator) of the above-described well, being first duly sworn on oath, says: That I have knowledge of the facts, statements, and matters herein contained and the log of the above-described well as filed and that the same are true and correct. So help me God.

(Signature) [Signature]
211 Brown Building, Wichita, Kansas (Address)

SUBSCRIBED AND SWORN TO before me this 18th day of July, 19 52
[Signature]
My commission expires 12-1-52 Notary Public.

CONSERVATION DIVISION
Wichita, Kansas
PLUGGING
FILE SEC 12 T 13 R 18
BOOK 30 LINE 15
2-52-20M

WELL LOG

M & L OIL CO.

Elevation: 2040 R.B.

Contractor: Quaker Drilling Co., Inc.

Commenced: 7-4-52

Dreilling No. 1
NW NW NW Sec. 12-13S-18W
Ellis County, Kansas

Completed: 7-14-52

Production: D&A

Casing Record:

Set 235' of 8 5/8 with 125 sacks

15-051-00131-00-00

(Figures indicate bottom of formations)

FORMATIONS:

Surface soil	40
Sand and Shale	85
Shale	150
Shale and Shells	251
Shale	300
Shale and Shells	700
Sand and Shale	955
Sand, Shale and Shells	1250
Shale and Shells	1397
Anhydrite	1354
Shale and Shells	2265
Lime and Shale	2355
Lime	2455
Lime and Shale	3145
Lime	3245
Lime and Shale	3277
Lime	3355
Shale and Lime	3410
Lime	3653
Shale and chert	3683
Shale	3701
Dolomite	3721 T.D.

FORMATION TOPS:

Anhydrite	1397	-	743
Heebner	3378	-	1238
Lansing	3423	-	1283
Conglomerate	3653	-	1513
Simpson	3683	-	1543
Arbuckle	3701	-	1561
T.D. (R)	3721	-	1581

I hereby certify that the above is a true and correct copy of Drillers Log of well drilled in the SE NW NW of Section 1, Township 13 South, Range 18 West, Ellis County, Kansas.

QUAKER DRILLING CO., INC.

By: Thomas M. Paul

Subscribed and sworn to before me this 16 day of July, 1952.

Wesley Bell
Notary Public

My Commission Expires: **RECEIVED**
September 14 1953 STATE CORPORATION

