

STATE OF KANSAS
STATE CORPORATION COMMISSION

Give All Information Completely
Make Required Affidavit
Mail or Deliver Report to:

Conservation Division
State Corporation Commission
800 Bitting Building
Wichita, Kansas


15-051-05897-0000
WELL PLUGGING RECORD

OR

FORMATION PLUGGING RECORD

Strike out upper line
when reporting plug-
ging off formations.

NORTH

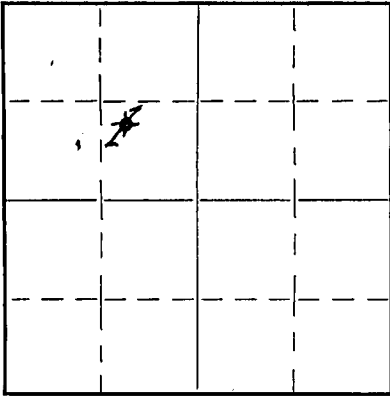

Locate well correctly on above
Section Plat

Ellis County, Sec. 25 Twp. 11 Rge. (E) 17 (W)

Location as "NE 1/4 NW 1/4 SW 1/4" or footage from lines 330'S 990E From W1/16 Corner NW 1/4

Lease Owner: Cities Service Oil Co.

Lease Name: Colahan B Well No. 3

Office Address: Bartlesville, Okla.

Character of Well (Completed as Oil, Gas or Dry Hole) Dry Hole

Date, well completed: Mar. 24, 1941 193

Application for plugging filed: Mar. 24, 1941 193

Application for plugging approved: Mar. 24, 1941 193

Plugging Commenced: Mar. 24, 1941 193

Plugging Completed: Mar. 24, 1941 193

Reason for abandonment of well or producing formation: Dry Hole

If a producing well is abandoned, date of last production 193

Was permission obtained from the Conservation Division or its agents before plugging was commenced? Yes

Name of Conservation Agent who supervised plugging of this well: C.T. Alexander

Producing formation: Arbuckle Lime Depth to top: 3740' Bottom: Total Depth of Well: 3758' Feet.

Show depth and thickness of all water, oil and gas formations.


OIL, GAS OR WATER RECORDS

CASING RECORD

Formation	Content	From	To	Size	Put In	Pulled Out
Arbuckle Lime	Dry Hole			85/8	1190'	None

Describe in detail the manner in which the well was plugged, indicating where the mud fluid was placed and the method or methods used in introducing it into the hole. If cement or other plugs were used, state the character of same and depth placed, from feet to feet for each plug set.

Filled with mud to 300' set wood plug dumped 12 sacks cement on top of plug, mud to 15' of surface set wood plug and dumped 8 sacks cement.

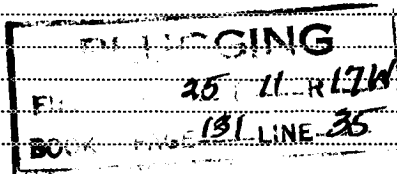

RCVD
04-05-41

(If additional description is necessary, use BACK of this sheet)

Correspondence regarding this well should be addressed to: R.C. Hauber

Address: Cities Service Oil Co. Great Bend, Kansas

STATE OF Kansas, COUNTY OF Russell, ss.

J.A. Cleverley (employee of owner) or (owner or operator) of the above-described well, being first duly sworn on oath, says: That I have knowledge of the facts, statements, and matters herein contained and the log of the above-described well as filed and that the same are true and correct. So help me God.

(Signature) *J.A. Cleverley*

Cities Service Oil Co. Russell, Kansas (Address)

SUBSCRIBED AND SWORN to before me this 26 day of March, 1941

My commission expires Jan. 26, 1942

R.J. Turner Notary Public.

WELL RECORD

15-051-05897-0000

Company Cities Service Oil Co. Well No. 3 Farm Colahan "B"
 Location 990' N. & 990' E. of W/4 Corner Sec. 25 T. 11 R. 17W
 Elevation 2078 County Illie State Illness
 Drlg. Comm. March 4, 1941 Contractor Huber Oil & Gas Company
 Drlg. Comp. March 23, 1941 Acid None
 T. D. 3658' Initial Prodi Dry - P. & A.

CASING RECORD:

1 1/2" @ 55' con. 60 sz Lehigh
 & 2 sz Aquagel
 8-5/8" @ 1190' con. 300 sz Ash
 Grove & 8 sz Aquagel

Top Landing 3310
 Top Conglomerate 3579
 Top Artesian 3740
 Penetration 18'
 Total Depth 3758

FORMATION RECORD:

surface rock 0-28
 shale 70
 shale & shells 680
 sand 770
 shale & shells 835
 sand & shale 920
 red bed, shale & shells 1190
 shale & red bed 1257
 anhydrite 1300
 shale & red bed 1390
 shale & shells 1595
 shale & salt 1730
 shale & shells 1840
 lime broken 2410
 lime & shale 2986
 lime 3237
 lime broken 3360
 lime 3602
 conglomerate 3634
 lime broken 3692
 cherty lime & shale 3743
 chert, lime & shale 3758 T. D.

Byfo: 500' 00
 1000' 00
 1500' 00
 2000' 00
 2500' 00
 3000' 00

PLUCCING
 FILE SEC 25 11-R 17W
 BOOK PAG 131-LINE 35