


STATE OF KANSAS
STATE CORPORATION COMMISSION

Form CP-4

WELL PLUGGING RECORD

Give All Information Completely
Make Required Affidavit
Mail or Deliver Report to:
Conservation Division
State Corporation Commission
212 No. Market
Wichita, Kansas

Ellis County. Sec. 25 Twp. 11 Rge. (E) 17 (W)
Location as "NE/CNWxSWx" or footage from lines 990N 430E of C
Lease Owner Cities Service Oil Company
Lease Name Colahan B Well No. 9
Office Address Box 553 Russell, Kansas
Character of Well (completed as Oil, Gas or Dry Hole) Oil
Date well completed 9-23 1941
Application for plugging filed 2-9 1966
Application for plugging approved 2-9 1966
Plugging commenced 2-9 1966
Plugging completed 3-10 1966
Reason for abandonment of well or producing formation Casing leak - lost hole

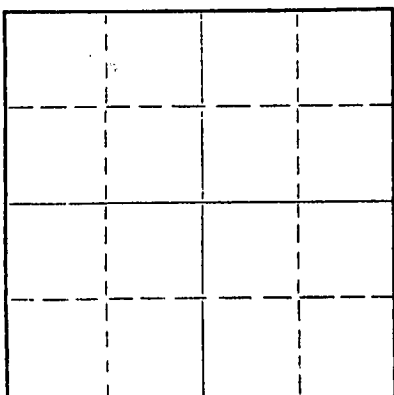

Locate well correctly on above
Section Plat

If a producing well is abandoned, date of last production December 19 65
Was permission obtained from the Conservation Division or its agents before plugging was commenced? Yes

Name of Conservation Agent who supervised plugging of this well Gilbert Leiker
Producing formation Arbuckle Depth to top 3420 Bottom 3448 Total Depth of Well 3520 Feet
Show depth and thickness of all water, oil and gas formations.

OIL, GAS OR WATER RECORDS

CASING RECORD

FORMATION	CONTENT	FROM	TO	SIZE	PUT IN	PULLED OUT
				8 5/8"	1068'	0
				5 1/2"	3520'	786'

Describe in detail the manner in which the well was plugged, indicating where the mud fluid was placed and the method or methods used in introducing it into the hole. If cement or other plugs were used, state the character of same and depth placed, from _____ feet to _____ feet for each plug set.

P & A well 3-10-66
Filled hole with heavy mud to 450' Put in rock bridge 450-440'. Put in 35 sacks cement 440-300'
Filled W/heavy mud to 50', put in rock bridge 50'-40' Filled hole to surface W/15 Sack cement.

RECEIVED
MAR 28 1966 RWD
03-28-1de

(If additional description is necessary, use BACK of this sheet)
Name of Plugging Contractor Halliburton Company
Address Hays, Kansas

STATE OF Kansas, COUNTY OF Russell, ss.
M. M. Hardin (employee of owner) or (owner or operator) of the above-described well, being first duly sworn on oath, says: That I have knowledge of the facts, statements, and matters herein contained and the log of the above-described well as filed and that the same are true and correct. So help me God.

(Signature) *M. M. Hardin*
Box 553 Russell, Kansas 67665
(Address)

SUBSCRIBED AND SWORN TO before me this 23rd day of March, 19 66

James F. Kyger
James F. Kyger
Notary Public.

My commission expires Oct. 5, 1968

Company Cities Service Oil Co. Well No. 9 Farm Colahan "B"
 Location 990' north and 430' east of Center Sec. 25 T. 11 R. 17-W
 Elevation 1946 County Ellis State Kansas
 Drlg. Comm. September 7, 1941 Contractor Mabee Oil & Gas Company
 Drlg. Comp. September 23, 1941 Acid 2000 gals. 10-15-41
 T. D. 3520' Initial Prod. Echometer Potential: 3000 oil, no water, 24 hrs.
(Ind. Cmp. 5768 bbls.)

CASING RECORD:

8-5/8" @ 1068' con. 300 sx Atlas, 8
 sx Aquagel & 2 sx C. O.
 5-1/2" @ 3520' con. 125 sx

FORMATION RECORD:

shale 0-25
 shale & shells 710
 sand 783
 shale & shells 970
 sand 995
 shale & shells 1050
 shale 1068
 red bed & shells 1130
 anhydrite & lime 1170
 red bed and shale 1290
 shale & shells 1465
 shale 1472
 salt & shale 1670
 lime & shale 1887
 lime 1928
 lime & shale 2020
 lime 2139
 lime & shale 2642
 shale 2735
 shale & shells 2826
 lime & shale 2950
 lime 3040
 lime & chert 3060
 lime 3134
 lime broken 3252
 lime 3386
 broken lime 3420
 lime 3430
 lime & chert 3473
 broken lime 3495
 lime & chert 3520

Top Arbuckle 3420' (-147A)
 Penetration 100'
 Total Depth 3520'

Drilled cement to 3497.

Oct. 3, 1941 - Perforated by Lane-Wells as follows:

12 shots 3476-80, 10 gals. fluid and show free oil 2 hrs.
 11 shots 3480-86 1/2, 1-3/4 bailers fluid (1 1/2 water and 1/2 oil) in 2 1/2 hrs. 1300' oil and 1 bailer water in 33 hrs. 1600' fluid in 45-3/4 hrs.

Oct. 5, 1941 - Drilled cement to 3511 and bailed hole dry at 8:00 P. M. 2 1/2 bailers fluid in 1 hr. at 9:00 P. M. 190' fluid in 3 hrs. at 12:15 A. M., Oct. 6, 1941. 350' fluid in 6 hrs. at 3:15 A. M. 700' fluid in 15 hrs. at 12:15 P. M.

Perforated 12 shots 3487-98. 800' fluid in 18 hrs. at 3:00 P. M.

Cemented back to 3448 S. L. M.

Oct. 31, 1941 - Perforated 55 shots 3420-30.
 150' fluid in 1 1/2 hrs.
 600' fluid in 8 1/2 hrs.
 1000' fluid in 13 1/2 hrs.

T. D. byfe: 500' 0°
 1500' 0°
 2000' 0°
 2500' 0°
 3000' 0°

RECEIVED
 STATE CORPORATION COMMISSION

FEB 9 1966
 02-09-Ed
 CONSERVATION DIVISION
 Kansas