

15-051 - 03439 - 0000


STATE OF KANSAS
STATE CORPORATION COMMISSION

Form CP-4

Give All Information Completely
Make Required Affidavit
Mail or Deliver Report to:
Conservation Division
State Corporation Commission
P. O. Box 17027
Wichita, Kansas 67217
NORTH

WELL PLUGGING RECORD

Ellis County, Sec 25 Twp 11S Rge. (E) 17 (W)
Location as "NE/CNW&SW&" or footage from lines SW NW SW
Lease Owner Cities Service Oil Company
Lease Name Colahan "B" Well No. 7
Office Address Box 553 Russell, Kansas 67665
Character of Well (completed as Oil, Gas or Dry Hole) Oil
Date well completed 8-5 19 41
Application for plugging filed 11-12 19 71
Application for plugging approved 11-15 19 71
Plugging commenced 2-25 19 72
Plugging completed 2-25 19 72
Reason for abandonment of well or producing formation Depleted

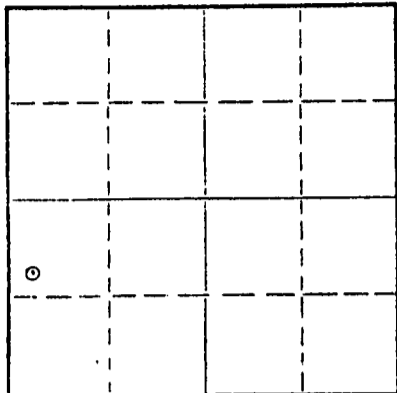

Locate well correctly on above
Section Plat

If a producing well is abandoned, date of last production April 19 70
Was permission obtained from the Conservation Division or its agents before plugging was commenced? Yes

Name of Conservation Agent who supervised plugging of this well Me. Leo Massey
Producing formation Arbuckle Depth to top 3477' Bottom 39' Pen. Total Depth of Well 3516 Feet
Show depth and thickness of all water, oil and gas formations.

OIL, GAS OR WATER RECORDS

CASING RECORD

FORMATION	CONTENT	FROM	TO	SIZE	PUT IN	PULLED OUT
				8 5/8"	348'	None
				5 1/2"	3479'	None

Describe in detail the manner in which the well was plugged, indicating where the mud fluid was placed and the method or methods used in introducing it into the hole. If cement or other plugs were used, state the character of same and depth placed, from _____ feet to _____ feet for each plug set.

Ran 100 Joints 2" tubing to 3000' and Halliburton pumped 1 Sx. Hulls,
25 Sx. Cement 3000' to 2750', 25 Sx. Gel 2700' to 540'. Pumped 75 Sx.
Cement 540' to surface.

RECEIVED
STATE CORPORATION COMMISSION
APR 7 1972
CONSERVATION DIVISION
Wichita, Kansas
04-07-72

(If additional description is necessary, use BACK of this sheet)
Name of Plugging Contractor Halliburton Company
Address Hays, Kansas

STATE OF Kansas, COUNTY OF Russell, ss.
E. W. Peterman (employee of owner) or (owner or operator) of the above-described well, being first duly sworn on oath, says: That I have knowledge of the facts, statements, and matters herein contained and the log of the above-described well as filed and that the same are true and correct. So help me God.

(Signature) *E. W. Peterman*


Box 553 Russell, Kansas 67665
(Address)

Subscribed and sworn to before me this 5th day of April, 1972

James F. Kyger

Notary Public.

10-5-72

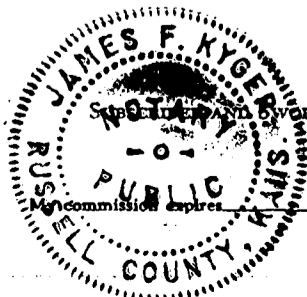

WELL RECORD

Company Cities Service Oil Co. Well No. 7 Farm Colahan "B"
 Location 950' south and 330' east of W/4 Corner Sec. 25 T. 11 R. 17W
 Elevation 2003 County Ellis State Kansas
 Orig. Comm. July 16, 1941 Contractor Mabee Oil & Gas Company
 Orig. Comp. August 5, 1941 Acid 2000 gals. (8-6-41)
 T. D. 3516' Initial Prod. Ecrometer Potential: 7658 oil, 0 water, 24 hours.

CASING RECORD:

8-5/8" @ 348' cem. 175 sz cement
 and 100 lbs. C. C.
 5-1/2" @ 3479' cem. 100 sz Monarch

Corr. Top Arbuckle
 Penetration
 Total Depth

3177 (-1474)
 39'
 3516

FORMATION RECORD:

shale & shells	0-585
sand & shale	660
iron shells & shale	750
sand & shale	758
shale, shells & red bed	1100
shale & red bed	1160
anhydrite	1215
shale & shells	1275
shale, shells & red bed	1450
shale & shells	1550
salt & shale	1700
shale & shells	1812
broken lime	2075
2075 = 2045 S. L. M.	
lime broken	2290
shale & lime	2335
sand & shale	2355
lime & shale	2638
shale & shells	2873
shale & lime	2927
lime	3182
lime broken	3197
3197 = 3227 S. L. M.	
lime broken	3271
lime	3478
3478 Rotary T. D. =	
3479 S. L. M.	
dolomite	3479-3516 T. D.

Fillup: 100' oil in 1 1/2 hrs. @ 3489
 250' oil in 3 1/2 hrs. @ 3494
 400' oil in 6 1/2 hrs. @ 3499
 1050' oil in 10 1/2 hrs. @ 3504
 2150' oil in 11 hrs. @ 3504
 2500' oil in 12 hrs. @ 3504
 2800' oil in 14 hrs. @ 3504

Syfo: 300' 00
 1000' 00
 1500' 00
 2000' 00
 2500' 00
 3000' 00

RECEIVED
 STATE CORPORATION COMMISSION
 NOV. 15 1971
 CONSERVATION DIVISION
 Wichita, Kansas

11-15-71

9-14-44 PBD 3502 w/ Tools.