


STATE OF KANSAS
STATE CORPORATION COMMISSION

Form CP-4

WELL PLUGGING RECORD

Give All Information Completely
Make Required Affidavit
Mail or Deliver Report to:
Conservation Division
State Corporation Commission
P. O. Box 17027
Wichita, Kansas 67217
NORTH

Ellis County, Sec. 25 Twp. 11S Rge. (E) 17 (W)
Location as "NE/CNW/SW" or footage from lines NE NW NW
Lease Owner Cities Service Oil Company
Lease Name Colahan "B" Well No. 2
Office Address Box 553 Russell, Kansas 67665
Character of Well (completed as Oil, Gas or Dry Hole) Oil
Date well completed 10-29 19 40
Application for plugging filed 4-28 19 72
Application for plugging approved 5-1 19 72
Plugging commenced 5-31 19 72
Plugging completed 5-31 19 72
Reason for abandonment of well or producing formation Depleted

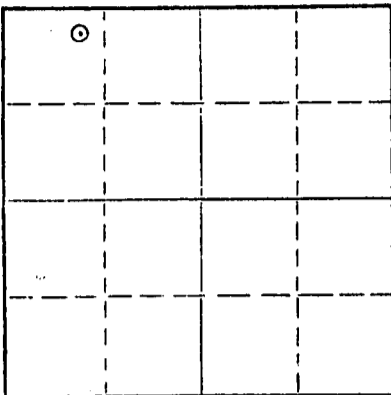

Locate well correctly on above
Section Plat

If a producing well is abandoned, date of last production 9-1 19 69
Was permission obtained from the Conservation Division or its agents before plugging was commenced? Yes

Name of Conservation Agent who supervised plugging of this well Mr. Leo Massey
Producing formation Arbuckle Depth to top 3568' Bottom 8' Pen Total Depth of Well 3576 Feet
Show depth and thickness of all water, oil and gas formations.

OIL, GAS OR WATER RECORDS

CASING RECORD

FORMATION	CONTENT	FROM	TO	SIZE	PUT IN	PULLED OUT
				8 5/8"	1175'	None
				5 1/2"	3570'	None

Describe in detail the manner in which the well was plugged, indicating where the mud fluid was placed and the method or methods used in introducing it into the hole. If cement or other plugs were used, state the character of same and depth placed, from _____ feet to _____ feet for each plug set.

Ran 2" tubing to 3050', Halliburton pumped (spotted) 25 sx. cement 3050' to 2735', 25 sx. gel and 1 sx. hulls 2735' to 600'. Pulled tubing to 600' and spotted 55 sx. cement 600' to surface, pulled tubing and filled hole to surface with 5 sx. cement. Cut off 8 5/8" & 5 1/2" casing and cleaned location.

RECEIVED
STATE CORPORATION COMMISSION


JUN 9 1972
06-09-72
CONSERVATION DIVISION
Wichita, Kansas

(If additional description is necessary, use BACK of this sheet)
Name of Plugging Contractor Halliburton Company
Address Hays, Kansas

STATE OF Kansas, COUNTY OF Russell, ss.
E. W. Peterman (employee of owner) or (owner) of the above-described well, being first duly sworn on oath, says: That I have knowledge of the facts, statements, and matters herein contained and the log of the above-described well as filed and that the same are true and correct. So help me God.

(Signature) *E. W. Peterman*
Box 553 Russell, Kansas 67665

8th day of June, 1972

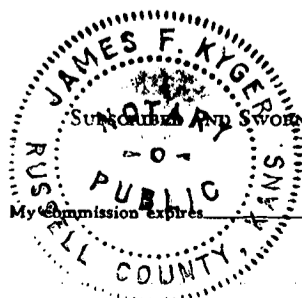

James F. Kyger
Notary Public.

WELL RECORD

Company Cities Service Oil Company Well No. 2 Farm Colahan "B"
 Location 330' south & 990' east of NW Cor. Sec. 25 T. 11 R. 17-4
 Elevation 2082 County Ellis State Kansas
 Orig. Comm. October 6, 1940 Contractor Mabee Oil & Gas Company
 Orig. Comp. October 27, 1940 Acid 2000 gallons October 28, 1940
 T. D. 3576' Initial Prod. Echo-Meter Potential: 2735 oil, no water, 2 1/2 hrs.

CASING RECORD:

8-5/8" @ 1175' cem. 300 sx Monarch and 10
 sx Aquagel
 5-1/2" @ 3570' cem. 100 sx Victor

Top Arbuckle 3568 -
 Penetration 2'
 Total Depth 3576

FORMATION RECORD:

surface rock 0-35
 shale 125
 shale & shells 455
 sand & shale 400
 shale & shells 850
 sand 910
 shale & shells 1100
 shale, shells & red bed 1172
 shale blue 1175
 shale & shells 1249
 anhydrite 1301
 shale & shells 1545
 salt & shale 1660
 shale & shells 1830
 shale & lime 1931
 broken lime 2034
 lime 2055
 broken lime 2290
 lime 2327
 lime & shale 2604
 shale & shells 2706
 lime & shale 2853
 lime 2898
 lime broken 3023
 lime 3295
 lime broken 3304
 lime 3498
 lime & shale 3535
 lime broken 3565
 shale & lime 3569
 lime 3572

Fillup:
 1000' oil in 40 mins.
 1400' oil in 1 hr. 20 mins.
 2200' oil in 2 hrs. 20 mins.
 2650' oil in 3 hrs. 20 mins.

Syfo: 500' 0°
 1000' 0°
 1500' 0°
 2000' 0°
 2500' 0°
 3000' 0°

3572 Rot. T. D. = 3571 S. L. W.
 dolomite 3571-3576 T. D.

RECEIVED
 STATE CORPORATION COMMISSION
 MAY 1 - 1972
 05-01-72
 CONSERVATION DIVISION
 Wichita, Kansas