


STATE OF KANSAS
STATE CORPORATION COMMISSION

WELL PLUGGING RECORD

Give All Information Completely
Make Required Affidavit
Mail or Deliver Report to
Conservation Division
State Corporation Comm.
245 North Water
Wichita, KS 67202

Barber County, Sec. 30 Twp. 31S Rge. 11W E/W
Location as "NE/CNW $\frac{1}{4}$ SW $\frac{1}{4}$ " or footage from lines
C SW/4
Lease Owner George R. Jones
Lease Name Nuckolls Well No. 1
Office Address Suite 1310, 125 No. Market, Wichita, Ks 67202
Character of Well (Completed as Oil, Gas or Dry Hole) dry hole

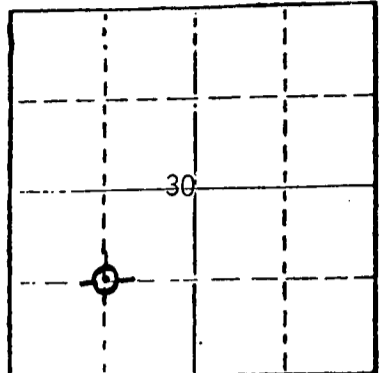

Locate well correctly on above
Section Plot

Date Well completed December 9, 1978 19
Application for plugging filed Dec. 9, 1978 19
Application for plugging approved Dec. 12, 1978 19
Plugging commenced Dec. 9, 1978 19
Plugging completed Dec. 9, 1978 19
Reason for abandonment of well or producing formation dry hole
If a producing well is abandoned, date of last production 19

Was permission obtained from the Conservation Division or its agents before plugging was commenced? Yes

Name of Conservation Agent who supervised plugging of this well William T. Owen
Producing formation none Depth to top Bottom Total Depth of Well 4320
Show depth and thickness of all water, oil and gas formations.

OIL, GAS OR WATER RECORDS

CASING RECORD

FORMATION	CONTENT	FROM	TO	SIZE	PUT IN	PULLED OUT
				Ran 7 fts of 20#	8 5/8" csg	
				set at 277'	Cemented w/225 sks. Class A	
				2% Gel 3% CC PD	2 a.m. 12/2/78	

Describe in detail the manner in which the well was plugged, indicating where the mud fluid was placed and the method or methods used in introducing it into the hold. If cement or other plugs were used, state the character of same and depth placed, from feet to feet for each plug set.
Plug #1 @ 270 w/45 sx
Plug and bridge @ 40' w/12 sx
Rathole 2 sx

RECEIVED
STATE CORPORATION COMMISSION

DEC 22 1978

12-12-78

CONSERVATION DIVISION
Wichita, Kansas

(If additional description is necessary, use BACK of this form)

Name of Plugging Contractor Gabbert-Jones, Inc.

STATE OF KANSAS COUNTY OF SEDGWICK, ss.
George R. Jones (employee of owner) or (owner or operator)
of the above-described well, being first duly sworn on oath, says: That I have knowledge of the facts, statements, and matters herein contained and the log of the above-described well as filed and that the same are true and correct. So help me God.

(Signature) *George R. Jones*
Suite 1310, 125 No. Market, Wichita, Ks 67202
(Address)

SUBSCRIBED AND SWORN TO before me this 21st day of December, 19 78

WILMA E. CLARK
NOTARY PUBLIC
Sedgwick County, Kansas
My Appt. Exp. Aug. 5, 1990

Wilma E. Clark
Wilma E. Clark Notary Public.

My commission expires

GABBERT-JONES, INC.
 WICHITA, KANSAS
 DRILLERS' WELL LOG

Nuckolls #1
 C SW Sec 30-318-11W
 Barber County Kansas

Commenced: 12-1-78

Completed: 12-9-78

OPERATOR: GEORGE JONES

Depth		Formation	Remarks
From	To		
0	65	Surface Clay	Ran 7 jts of 20# 8 5/8" cog set @ 277' Cemented w/ 225 sks Class A 2X Gel
285	285	Redrock-Redbed-Shale	
225	280	Redbed	3X CC PD @ 2:00 a.m. 12-2-78
280	1755	Shale	
1755	2425	Shale-Lime	
2425	3510	Lime-Shale	
3510	3735	Shale-Lime	
3735	4005	Lime-Shale	
4005	4320	Lime	
	4320 - TD		DRY & ABANDONED

STATE OF KANSAS)
) SS
 COUNTY OF SEDGWICK)

I, the undersigned, being duly sworn on oath, state that the above
 Drillers' Well Log is true and correct to the best of my knowledge and belief and
 according to the records of this office.

GABBERT-JONES, INC.

James S. Sutton II
 JAMES S. SUTTON II

Subscribed and sworn to before me this 15th day of December, 1978.

Elizabeth J. Edwards
 ELIZABETH J. EDWARDS-NOTARY PUBLIC

My Commission expires February 6, 1979.

