


STATE OF KANSAS
STATE CORPORATION COMMISSION

15-05104701-00-00
WELL PLUGGING RECORD

Give All Information Completely
Make Required Affidavit
Mail or Deliver Report to:
Conservation Division
State Corporation Commission
800 Bitting Building
Wichita, Kansas

Ellis County, Sec. 31 Twp. 13S Rge. 19W (E) (W)

Location as "NE/CNW/SW" or footage from lines. SW SE NE
Lease Owner The Texas Company
Lease Name G. E. Riedel Well No. 7
Office Address 614 Bitting Building, Wichita, Kansas
Character of Well (completed as Oil, Gas or Dry Hole) Dry
Date well completed March 31 19 53
Application for plugging filed March 31 19 53
Application for plugging approved (Verbal 3-31) April 2 19 53
Plugging commenced March 31 19 53
Plugging completed April 1 19 53
Reason for abandonment of well or producing formation _____

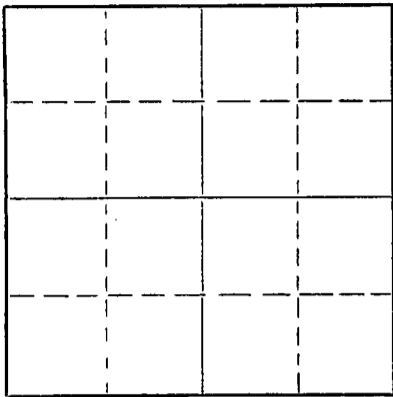

Locate well correctly on above Section Plat

If a producing well is abandoned, date of last production _____ 19____
Was permission obtained from the Conservation Division or its agents before plugging was commenced? Yes

Name of Conservation Agent who supervised plugging of this well Mr. Eldon Petty
Producing formation _____ Depth to top _____ Bottom _____ Total Depth of Well 3926 Feet
Show depth and thickness of all water, oil and gas formations.

OIL, GAS OR WATER RECORDS

CASING RECORD

FORMATION	CONTENT	FROM	TO	SIZE	PUT IN	PULLED OUT
				10-3/4"	279'	0'

Describe in detail the manner in which the well was plugged, indicating where the mud fluid was placed and the method or methods used in introducing it into the hole. If cement or other plugs were used, state the character of same and depth placed, from _____ feet to _____ feet for each plug set.

PLUGGED AS FOLLOWS:

3926' to 270' - Heavy Mud
270' - Wooden Plug
270' to 235' - 20 Sacks Cement
235' to 33' - Heavy Mud
33' - Wooden Plug
33' to Bottom of Cellar -
12 Sacks Cement

(If additional description is necessary, use BACK of this sheet)

Name of Plugging Contractor Stickle Drilling Company
Address Box 202, Great Bend, Kansas

STATE OF Kansas, COUNTY OF Sedgwick, ss.
M. C. Harrell (employee of owner) or (owner or operator) of the above-described well, being first duly sworn on oath, says: That I have knowledge of the facts, statements, and matters herein contained and the log of the above-described well as filed and that the same are true and correct. So help me God.

(Signature) M. C. Harrell
614 Bitting Building, Wichita, Kansas (Address)

SUBSCRIBED AND SWORN TO before me this 7th day of April, 19 53

My commission expires September 20, 1956

Howard Kistler Notary Public.

PLUGGING
FILE SEC 31 T 13 R 19W
BOOK PAGE 29 LINE 26

24-2675-5 2-52-20M

RECEIVED
STATE CORPORATION COMMISSION
APR 9 - 1953
CONSERVATION DIVISION
Wichita, Kansas

LOG OF WELL

Form PO-214 Sheet 1 (12-50)20M

G. E. RIEDEL NO. 7

SHEET 1

OWNER The Texas Company DIVISION Oklahoma DATE MADE April 7, 1953
 DISTRICT Kansas LEASE G. E. Riedel WELL NO. 7
 STATE Kansas COUNTY OR PARISH Ellis TWP. 13S RANGE 19W SEC. 31
 LOCATION OF WELL SW SE NE

COMMENCED RIGGING UP 3-18-53 COMMENCED DRILLING 3-18-53 COMPLETED DRILLING 3-31-53
 DAY DRILLER _____ NIGHT DRILLER _____ CONTRACTOR Stickle Drilling Co.
 CABLE FROM _____ TO _____ ROTARY FROM 0 TO 3926' COMPANY RIG NO. _____
 TOTAL DEPTH 3926' MEASURED BY M. C. Harrell ELEVATION KB--2248
DP--2246
GL--2244

CASING RECORD

SIZE	WEIGHT	PUT IN WELL		PULLED OUT		LOST IN WELL		SHOES		PACKERS			
		FEET	INS.	FEET	INS.	FEET	INS.	LENGTH	MAKE	KIND	LENGTH	SET AT	
<u>10-3/4"</u>	<u>29#</u>	<u>280</u>		<u>(SW, New Casing)</u>									

10-3/4" casing set at 279' with 225 sacks cement, 50# Flocele & 200# CC, cement circulated.

WAS CASING CEMENTED? _____ IF SO, HOW MANY SACKS OF CEMENT USED? _____
 LINER: STATE SIZE AND WEIGHT _____ WHERE SET _____ FT. AND INS. BLANK _____ FT. AND INS. PERFORATED _____
 HOW PUT TOGETHER _____ COUPLING _____ FLUSH-JOINT _____ INSERTED _____
 REMARKS: _____

EQUIPMENT RECORD

TUBING				SUCKER RODS			PUMPING OUTFIT
SIZE	WEIGHT	FEET	INS.	FEET	INS.	SIZE AND KIND	DESCRIPTION, KIND, QTS, ETC.

Completed Plugging 4-1-53

FLOWING, PUMPING, GASSEY OR DRY Dry PRODUCTION FIRST 24 HOURS _____ PRODUCTION SETTLED _____
 IF GAS WELL, OPEN FLOW CAPACITY _____ SHUT IN PRESSURE _____ ROCK PRESSURE _____
 KIND OF SHOT _____ SIZE OF SHOT, QUARTS _____
 NUMBER OF SHELLS _____ SIZE OF SHELLS _____ INCHES, DIAMETER _____
 LENGTH OF SHELLS _____ FEET _____ INCHES _____ TOP OF SHOT _____
 BOTTOM OF SHOT _____ ANCHOR _____ WELL BRIDGED TO _____
 TOTAL DEPTH OF WELL _____ NUMBER OF SHOT _____ PRODUCTION BEFORE SHOT _____ BBLs. PER DAY _____
 PRODUCTION AFTER SHOT _____ BBLs. PER DAY. SHOT FURNISHED BY _____
 NAME OF SHOOTER _____ SHOT INSPECTED _____ BY _____ (COMPANY EMPLOYEE)
 COMMENCED DRILLING DEEPER _____ COMPLETED _____ DRILLING DEEPER _____

TOTAL DEPTH _____ PRODUCTION FIRST 24 HOURS _____ PRODUCTION SETTLED _____
 REMARKS: G. E. Riedel #7
Irvin Pool
T.D. 3926'
Completed Drilling 3-31-53
Completed Plugging 4-1-53

NOTE: IF WELL WAS DRY, STATE UNDER REMARKS, WHEN, HOW, AND BY WHOM PLUGGED.
 STATE UNDER REMARKS ANYTHING OF INTEREST NOT COVERED IN LOG.
 THE SPACE PROVIDED FOR REMARKS IS NOT SUFFICIENT WRITE ON BOTTOM OF LAST SHEET OF LOG.

PLUGGING
 FILE SEC 31 T 13 R 19W
 BOOK PAGE 89 LINE 26

TOTAL NUMBER OF SHEETS _____

LOG OF WELL

SHEET No. 2District **Kansas**Owner **The Texas Company Farm G. E. Riedel**Well No. **7**

FORMATION		AMOUNT	COLOR	HARD OR SOFT	DEPTH CORES TAKEN	REMARKS
Shale & Shells	0	280				<u>CASING RECORD:</u> 10-3/4" casing set at 279' with 225 sacks cement, 50# Flocele & 200# CC, cement circulated. <u>ELEVATIONS:</u> KB-----2248 DF-----2246 GL-----2244 <u>TIPS:</u> Cimarron Dolo---1536 Topeka-----3240 Heebner-----3492 Lansing-----3534 Conglomerate---3838 Arbuckle-----3922
Shale & Lime	500	220				
Shale & Shells	1285	785				
Shale	1532	247				
Anhydrite	1585	53				
Shale & Shells	2200	615				
Shale & Lime	2576	376				
Lime & Shale	2685	109				
Shale & Lime	2825	140				
Lime & Shale	2925	100				
Shale & Lime	3020	95				
Lime & Shale	3627	607				
Lime	3850	223				
Conglomerate	3920	70				
Arbuckle	3926	06				
Total Depth	3926					

REMARKS:

- 3-29-53 Ran DST #1 from 3734-52', open 1 hour, recovered 5' mud. SBHP 30# in 30 minutes.
- 3-31-53 Ran DST #2 from 3690-3705', open 1-1/2 hours, recovered 3' mud. SBHP zero in 30 minutes. Drilled to 3926' in Lime. Ran Schlumberger Survey.
- 4-1-53 Plugged and abandoned.