


STATE OF KANSAS
STATE CORPORATION COMMISSION

15-051-21999-00-00
WELL PLUGGING RECORD

Give All Information Completely
Make Required Affidavit
Mail or Deliver Report to
Conservation Division
State Corporation Comm.
245 North Water
Wichita, KS 67202

Ellis County, Sec. 15 Twp. 13s Rge. 18 XE/W
Location as "NE/CNW $\frac{1}{4}$ SW $\frac{1}{4}$ " or footage from lines
NW SW SE

Lease Owner Stevens Oil Company
Lease Name Pfeifer Well No. #0
Office Address 2522 Felten Dr., Hays Kansas 67601
Character of Well (Completed as Oil, Gas or Dry Hole)

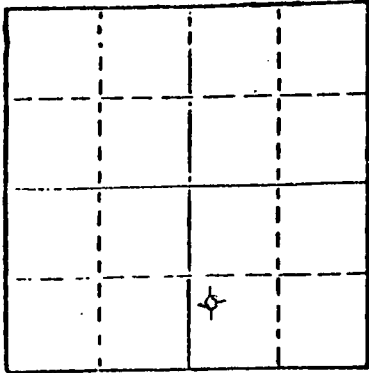

Locate well correctly on above
Section Plat

Dry Hole
Date Well completed 10-13 1980
Application for plugging filed 10-13 1980
Application for plugging approved 10-13 1980
Plugging commenced 10-13 1980
Plugging completed 10-13 1980
Reason for abandonment of well or producing formation

Dry Hole
If a producing well is abandoned, date of last production 19

Was permission obtained from the Conservation Division or
its agents before plugging was commenced? Yes

Name of Conservation Agent who supervised plugging of this well Marion Schmidt
Producing formation _____ Depth to top _____ Bottom _____ Total Depth of Well 3643'
Show depth and thickness of all water, oil and gas formations.

OIL, GAS OR WATER RECORDS

CASING RECORD

FORMATION	CONTENT	FROM	TO	SIZE	PUT IN	PULLED OUT
Surface		0	680'	5 5/8	658'	0

Describe in detail the manner in which the well was plugged, indicating where the mud fluid was placed and the method or methods used in introducing it into the hold. If cement or other plugs were used, state the character of same and depth placed, from _____ feet to _____ feet for each plug set.

1st Plug set at 600' with 80 sacks of 50-50 Poz 6% gel

2nd Plug set at 40' with 10 sacks of 50-50 Poz 6% gel

5 sacks cement in rathole

(If additional description is necessary, use BACK of this sheet)

Name of Plugging Contractor Sun Oilwell Cementing

RECEIVED
STATE CORPORATION COMMISSION
NOV 10 1980
CONSERVATION DIVISION
Wichita, Kansas
11-06-80

STATE OF Kansas COUNTY OF Graham
Jerry M. Helberg (employee of owner) or (owner or operator)
of the above-described well, being first duly sworn on oath, says: That I have knowledge of the facts, statements, and matters herein contained and the log of the above-described well as filed and that the same are true and correct. So help me God.


(Signature)

Jerry M. Helberg
(Address)

SUBSCRIBED AND SWORN TO before me this 4th day of Nov., 1980

Janice Robinson
Notary Public.

My commission expires Dec. 4, 1983

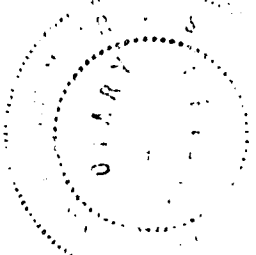

DRILLERS LOG

PFEIFER #2

CASING RECORD:

8 5/8 set at 658'

TOTAL DEPTH:

680'

DESCRIPTION:

NW SW SE
15-13S-18 Ellis County, Kansas

OPERATOR: Stevens Oil Company

CONTRACTOR: Helberg Oil Company

COMMENCED: September 28, 1980

COMPLETED: October 13, 1980

15-051-21999-00-00

FORMATION	FROM	TO	REMARKS
Shale	0	40	
Shale & Sand	40	215	
Shale	215	436	
Shale & Sand	436	680	
Shale	680	1075	
Shale & Sand	1075	1378	
Anhydrite	1378	1391	
Shale	1391	1526	
Shale	1526	1738	
Shale & Sand	1738	1892	
Lime & Shale	1892	1995	
Shale	1995	2153	
Shale	2153	2331	
Lime & Shale	2331	2412	
Lime & Shale	2412	2560	
Lime & Shale	2560	2709	
Lime & Shale	2709	2770	
Lime & Shale	2770	2905	
Shale	2905	2998	
Lime & Shale	2998	3093	
Lime	3093	3171	
Lime	3171	3212	
Lime	3212	3269	
Lime	3269	3276	
Lime & Shale	3276	3300	
Lime & Shale	3300	3340	
Lime & Shale	3340	3380	
Shale	3380	3436	
Shale	3436	3449	
Lime	3449	3495	
Lime	3495	3506	
Lime	3506	3543	
Lime	3543	3593	
Lime	3593	3643	
T.D.	3643		D. & A

I Certify that the above is a true and correct copy of the log to the best of my knowledge.

HELBERG OIL COMPANY

Jerry M. Helberg
Jerry M. Helberg

Subscribed and sworn to before me this 30 day of October, 1980

Boye E. ...
Notary Public

My commission expires



10-30-80
SEAL OF THE STATE OF KANSAS
NOTARY PUBLIC