


Give All Information Completely
Make Required Affidavit
Mail Or Deliver Report to:
Conservation Division
State Corporation Commission
800 Bitting Building
Wichita, Kansas

15057-06763-0000
WELL PLUGGING RECORD

NORTH

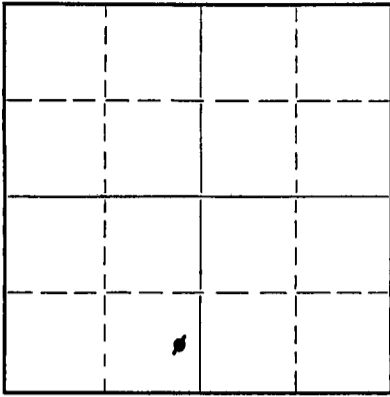

Locate well correctly on above
Section Plat

Ellis County. Sec. 1 Twp. 13 Rge. (E) 18 (W)
Location as "NE/CNW $\frac{1}{4}$ SW $\frac{1}{4}$ " or footage from lines C E/2 SE SW
Lease Owner DOLEY OIL COMPANY
Lease Name CRISSMAN Well No. 1
Office Address Hays, Kansas
Character of Well (completed as Oil, Gas or Dry Hole) oil
Date well completed February 13, 1948 19
Application for plugging filed November 17, 1950 19
Application for plugging approved November 17, 1950 19
Plugging commenced November 18, 1950 19
Plugging completed November 21, 1950 19
Reason for abandonment of well or producing formation Depleted

If a producing well is abandoned, date of last production July 1950 19
Was permission obtained from the Conservation Division or its agents before plugging was commenced? Yes

Name of Conservation Agent who supervised plugging of this well Petty
Producing formation Arbuckle Depth to top 3620 Bottom 3670 Total Depth of Well 3670 Feet
Show depth and thickness of all water, oil and gas formations.

OIL, GAS OR WATER RECORDS

CASING RECORD

Formation	Content	From	To	Size	Put In	Pulled Out
surface			160'	8-5/8	160	cemented 100 sacks
Arbuckle			3670'	5 $\frac{1}{2}$ "	3670	756'

Describe in detail the manner in which the well was plugged, indicating where the mud fluid was placed and the method or methods used in introducing it into the hole. If cement or other plugs were used, state the character of same and depth placed, from.....feet to.....feet for each plug set.

Hole was filled with chat from 3656 (plug back depth) to 3620' and dumped four sacks cement at 3620'.

5 $\frac{1}{2}$ " pipe pulled in two at 756 feet and 756' of pipe was pulled out.

rock bridge was built at 756' to 645' and mud was filled to 160' rock bridge at 160' and 15 sacks of cement was dumped on bridge. Hole was filled with mud to 40' and hole was filled to bottom of cellar with 10 sacks of cement.

RECEIVED
01-04-51
JAN 4 1951
CONSERVATION DIVISION
WICHITA, KANSAS

(If additional description is necessary, use BACK of this sheet)

Correspondence regarding this well should be addressed to Doley Oil Company
Address Hays, Kansas

STATE OF Kansas, COUNTY OF Ellis, ss.

.....(employee of owner) or (owner or operator) of the above-described well, being first duly sworn on oath, says: That I have knowledge of the facts, statements, and matters herein contained and the log of the above-described well as filed and that the same are true and correct. So help me God.

(Signature)

E. D. Witt

Hays, Kansas
(Address)

SUBSCRIBED AND SWORN to before me this 3rd day of January, 1951.

John L. Spiess
Notary Public.

My commission expires

May 9, 1953

22-7377-B 4-49-10M

PLUGGING
FILE SEC LT 13 R 185
BOOK PAGE 44 LINE 37

WELL LOG CRISMAN NO. 1

Deley Oil Co. - Lease Owners
 Donald T. Ingling - Contractor
 Total Depth: 3670'
 Commenced: January 20, 1948
 Completed: February 13, 1948
 Casings: 160' of 8-5/8"
 3670' of 5-1/2"

Sec. 1, Twp. 13, Range 18W
 Location: C E/2 SE SW
 County: Ellis (Kansas)
 Elevation: 2104'
 Production:

15-051-26763-0000
 Figures below indicate bottom of formation:

201 Blue Shale	2355 Lime & Shale
470 Shale & Shells	2365 Lime - Sandy
490 Sand	2470 Lime & Shale
515 Shale & Red Bed	2477 Lime
545 Shale & Shells, Sand	2487 Shale - Red
810 Shale & Shells	2500 Lime
1065 Sand	2550 Lime & Shale
1200 Shale	2595 Lime
1220 Sand	2635 Shale & Lime
1225 Shale	2680 Lime - Hard
1345 Shale & Shells	2690 Shale
1380 Lime - Anhydrite	2700 Lime
1495 Shale & Shells	2725 Shale & Lime
1508 Iron-Pyrite	2735 Shale
1553 Shale & Shells	2780 Shale & Lime
1557 Iron-Pyrite	2802 Shale & Shells
1590 Iron-Pyrite & Shale	2815 Lime
1605 Iron-Pyrite	2820 Shale & Lime
1645 Shale & Shells	2855 Shale & Shells
1680 Lime - Hard	3133 Lime & Shale
1735 Shale & Shells	3140 Lime
1815 Salt	3175 Lime & Shale
2000 Shale & Shells	3235 Lime
2030 Lime	3260 Lime & Shale
2080 Lime & Shale	3615 Lime
2100 Shale & Shells	3645 Conglomerate
2115 Lime	3670 Arbuckle
2200 Lime & Shale	3670 TOTAL DEPTH
2250 Red Shale - Sticky	
2245 Lime - Sandy	

I hereby certify that this is a true and correct log of the abovementioned well.

DONALD T. INGLING

Donald T. Ingling

STATE OF KANSAS |
 | SS.
 SEDGWICK COUNTY |

Subscribed and sworn to before me, a Notary Public in said County and State this 16th day of February, 1948.

PLUGGING
 FILE SEC. LT 13 R 184
 BOOK PAGE 44 LINE 37

Leah S. Landrum

 Notary Public

My commission expires: 4/10/48