

STATE OF KANSAS
STATE CORPORATION COMMISSION

Form CP-4

Give All Information Completely
Make Required Affidavit
Mail or Deliver Report to:
Conservation Division
State Corporation Commission
212 No. Market
Wichita, Kansas 67202

15-057-01683-00-00
WELL PLUGGING RECORD

Ellis County. Sec. 1 Twp. 13 Rge. 18 (E) W (W)

Location as "NE/CNW&SW&" or footage from lines N₂ NW NE

Lease Owner Messman - Rinehart Oil Co.

Lease Name Staab Est. Well No. # 1

Office Address 1432 Wichita Plaza ; Wichita, Kans. 67202

Character of Well (completed as Oil, Gas or Dry Hole) _____

Date well completed _____ 19 70

Application for plugging filed November 19 70

Application for plugging approved November 19 70


Plugging commenced November 14 19 70

Plugging completed November 18 19 70

Reason for abandonment of well or producing formation _____

If a producing well is abandoned, date of last production _____ 19 _____

Was permission obtained from the Conservation Division or its agents before plugging was commenced? Yes

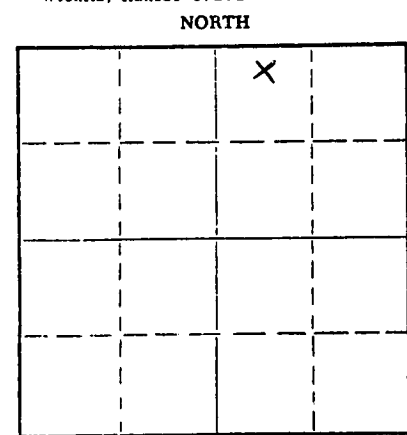

Locate well correctly on above Section Plat

Name of Conservation Agent who supervised plugging of this well Leo Massey

Producing formation _____ Depth to top _____ Bottom _____ Total Depth of Well _____ Feet

Show depth and thickness of all water, oil and gas formations.

OIL, GAS OR WATER RECORDS

CASING RECORD

| FORMATION | CONTENT | FROM | TO | SIZE | PUT IN | PULLED OUT |
|-----------|------------------------------|------|----|-------|--------|------------|
| | RECEIVED | | | 8 5/8 | 234 | None |
| | STATE CORPORATION COMMISSION | | | 4 1/2 | 3630 | 2940 |
| | DEC 21 1970 | | | | | |
| | CONSERVATION DIVISION | | | | | |
| | Wichita, Kansas | | | | | |

Describe in detail the manner in which the well was plugged, indicating where the mud fluid was placed and the method or methods used in introducing it into the hole. If cement or other plugs were used, state the character of same and depth placed, from _____ feet to _____ feet for each plug set.

November 14, 1970 Plugged off bottom. Dumped sand to 3530'. Mixed and dumped 4 sx of cement, to 3480'.

November 18, 1970 Plugged off top. Globe Oil Well Cementing Co. mixed and pumped down 8 5/8" surface casing : 5 sx hulls, 25 sx gel, released plug, mixed and pumped 130 sx + 6 % gel cement.

(If additional description is necessary, use BACK of this sheet)

Name of Plugging Contractor Russ Casing Pulling, Inc.

Address P. O. Box 1082 ; Great Bend, Kansas 67530

STATE OF Kansas, COUNTY OF Sedgwick, ss.
J. A. Gilliland

(employee of owner) or (owner or operator) of the above-described well, being first duly sworn on oath, says: That I have knowledge of the facts, statements, and matters herein contained and the log of the above-described well as filed and that the same are true and correct. So help me God.

(Signature) J. A. Gilliland

J. A. Gilliland

(Address)

SUBSCRIBED AND SWORN to before me this 22nd day of December, 1970

Arlene L. Sloop
Arlene L. Sloop Notary Public.



NO. 1 A. STAAB ESTATE

Well Record:

Location: Ctr. N/2 NW/4 NE/4
Section 1-135-18W
Ellis County, Kansas

Operator: Messman-Rinehart Oil Company
1432 Wichita Plaza Bldg.
Wichita 2, Kansas

Contractor: Messman-Rinehart Oil Company
1432 Wichita Plaza Bldg.
Wichita 2, Kansas

Commenced: May 29, 1963
Completed: June 10, 1963
(Rotary)
Elevation: 2062' K/S
Production: Oil

Casing Record: 8-5/8" @ 234' w/180 sx. cement
4-1/2" @ 3630' w/40 sx. cement

*** LOG ***

| | |
|----------------|-------------|
| Shale & Clay | 40 |
| Shale & Shells | 750 |
| Bakota Sand | 960 |
| Sand | 990 |
| Shale & Shells | 1300 |
| Anhydrite | 1345 |
| Shale & Shells | 1890 |
| Shale & Lime | 2095 |
| Shale & Lime | 2230 |
| Lime | 2384 |
| Lime & Shale | 2530 |
| Lime | 2660 |
| Lime & Shale | 3055 |
| Lime | 3630 R.T.D. |

Sample Tops:

1300' - Anhydrite (-762)
3277' - Heebner (-1218)
3351' - Lansing (-1280)
3300' - Toronto (-1238)
3564' - Base Kansas City (-1502)
3579' - Cherty Conglomerate (-1517)
3585' - Arbuckle (-1523)

The undersigned, MESSMAN-RINEHART OIL COMPANY, hereby certifies that the above log is a true and correct log of the formation encountered in drilling the above well as reflected by the Daily Drilling Reports.

MESSMAN-RINEHART OIL COMPANY

By: J. A. Gilliland
J. A. Gilliland

Subscribed and sworn to before me
this 25th day of June, 1963

Barbara J. Scott
Barbara J. Scott, Notary Public

My Commission Expires: December 1, 1964

COMPLETION DATA

6-15-63 - Moved in cable tools

6-16-63 - Drilled out cement to 3624 ft., Logged hole, Perf. 3598-3608' w/4" ft.,
Let set overnight, treated with 250 gal. mud acid, baled 25 gal. oil
Treated with 500 gal. 15% acid, subd. 6 BOPH, no wtr.
Putting on pump - (acid treatment pressured up to 750# and broke to
vacuum in 6 hrs.)

MESSMAN-RINEHART OIL COMPANY

By: Roger L. Messman
Roger L. Messman