


STATE OF KANSAS  
STATE CORPORATION COMMISSION

15-051-0007600-00  
WELL PLUGGING RECORD

Give All Information Completely  
Make Required Affidavit  
Mail or Deliver Report to:  
Conservation Division  
State Corporation Commission  
800 Biting Building  
Wichita, Kansas

Ellis County, Sec. 15 Twp. 13 Rge. 18 (X) (W)

Location as "NE/CNW/SW" or footage from lines NE NE SW  
Lease Owner Petroleum, Inc.  
Lease Name Braun 'A' Well No. 1  
Office Address 305 East Third, Wichita, Kansas  
Character of Well (completed as Oil, Gas or Dry Hole) Dry Hde  
Date well completed August 27, 1952  
Application for plugging filed August 27, 1952  
Application for plugging approved August 27, 1952  
Plugging commenced August 27, 1952  
Plugging completed August 27, 1952  
Reason for abandonment of well or producing formation Dry Hole

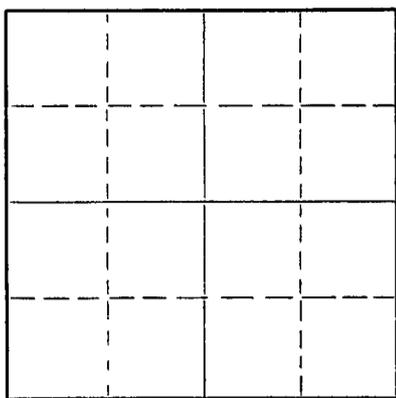

Locate well correctly on above Section Plat

If a producing well is abandoned, date of last production 19  
Was permission obtained from the Conservation Division or its agents before plugging was commenced? Yes

Name of Conservation Agent who supervised plugging of this well Mr. Eldon Petty  
Producing formation Depth to top Bottom Total Depth of Well 3810 Feet  
Show depth and thickness of all water, oil and gas formations.

OIL, GAS OR WATER RECORDS

CASING RECORD

FORMATION	CONTENT	FROM	TO	SIZE	PUT IN	PULLED OUT
				8 5/8"	216'	None

Describe in detail the manner in which the well was plugged, indicating where the mud fluid was placed and the method or methods used in introducing it into the hole. If cement or other plugs were used, state the character of same and depth placed, from feet to feet for each plug set.

Mudded up to 210' and set wooden plug at 210'.  
Cemented and displaced 15 sacks cement through  
drill pipe onto plug at 210'. Mudded up to  
40' and set second wooden plug. Filled hole  
with 10 sacks cement to bottom of well cellar.

RECEIVED  
CONSERVATION DIVISION  
Wichita, Kansas  
52  
09-01-52

(If additional description is necessary, use back of this sheet)  
Name of Plugging Contractor Garvey Drilling Company  
Address R. R. #2, Great Bend, Kansas

STATE OF KANSAS, COUNTY OF SEDGWICK, ss.  
W. W. Fisher (employee of owner) of ~~owner~~ operator of the above-described well, being first duly sworn on oath, says: That I have knowledge of the facts, statements, and matters herein contained and the log of the above-described well as filed and that the same are true and correct. So help me God.

(Signature) W W Fisher  
305 East Third, Wichita 2, Kansas  
(Address)

SUBSCRIBED AND SWORN TO before me this 4th day of September, 1952

Charlotte Hardner  
Notary Public.

My commission expires October 13, 1954

PLUGGING  
FILE SEC 15 T 13 R 18  
BOOK PAGE 40 LINE 39

DRILLER'S LOG BRAIN #1

Petroleum, Inc., Operator

Section 15, Twp. 13S, Rge. 18W

Garvey Drilling Company, Contractor

Location: NE NE SW

Drilling Commenced: August 16, 1952

County: Ellis County, Kansas

Drilling Completed: August 27, 1952

Production: D & A

Casing Records: 8 5/8" @ 216' w/140 sax

Figures below indicate bottom of formations:

70	Clay and Shale
216	Shale & Shells
280	Shale
500	Shale & Shells
870	Shale, Shells & Sand
1050	Sand & Shale
1398	Shale & Shells
1440	Anhydrite
2050	Shale & Shells
2155	Lime & Shale
2400	Lime
3160	Lime & Shale
3725	Lime
3780	Conglomerate
3800	Lime
3800'	R.T.D.

Top:

Heebner:	3384 (-1254)
Lansing:	3434 (-1304)
Conglomerate:	3695 (-1505)
Arbuckle:	3784 (-1654)

I hereby certify that this is a true and correct log of the above mentioned well.

PETROLEUM, INC.

By W.W. Fisher

RECEIVED  
STATE CURATOR'S OFFICE  
COMMISSION

STATE OF KANSAS

COUNTY OF SEDGWICK

CONSERVATION DIVISION  
Wichita, Kansas

Subscribed to and sworn to before me, a Notary Public, in said County and State, this 4th day of September, 1952.

Charlotte Thuman  
Notary Public

My commission expires: October 13, 1954.

15 13 182  
BOOK 46 39