

WELL RECORD

Company Cities Service Oil Company No. 6 Farm Rumsey


Location 1692' S, 330' E, of Center Sec. 23 T. 11 R. 17W

Elevation 1950 County Ellis State Kansas

Drlg. Comm. Nov. 30, 1938

Date Completed Dec. 22, 1938 Initial Production 593 oil, 0 water

Drlg. Contractor: J. E. Mabee Company

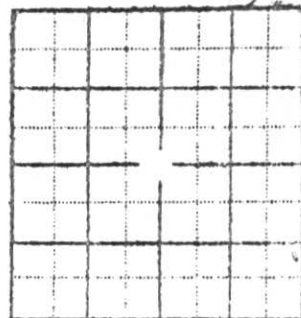

Total Depth 3416'

CASING RECORD:

10-3/4" cemented @ 998' w/ 500 sx
7" @ 3410' w/ 150 sx cement & 12 Aquagel

Top Arbuckle 3410
Penetration 6
Total Depth 3416

FORMATION RECORD:

shale & shells	0-103
shale shells & sand	440
shale & shells	670
shale	720
sand	800
red bed	930
shale & shells	1002
cement & shale	1137
shale	1150
anhydrite	1178
shale & shells	1400
correction	1400 = 1410
shale & shells	1498
salt	1675
shale	1746
shale & shells	1790
broken lime	1853
lime	1942
lime broken	1992
lime & shale	2060
lime	2099
lime broken	2159
shale & shells	2190
lime	2235
shale & shells	2340
lime	2360
shale & shells	2372
lime & shale	2436
SLM	2436 = 2463
lime & shale	2658
lime broken	2685
lime	3006
lime & chert	3026
lime	3141
(very strong oil odor 3080)	
shale	3157
lime	3410
(strong oil odor 3210)	
core pyrite & lime	3410-11
lime	3416 T. D.

Fill Up: 1150' in 20 min.
2250' in 45 min.
2800' in 2 hrs.
2875' in 5 hrs.

SYFO: 1500' 1°
2000' 0°
2500' 0° O. K.
3000' 0°

RECEIVED
STATE CORPORATION COMMISSION
NOV 15 1971
CONSERVATION DIVISION
Wichita, Kansas