


WELL PLUGGING RECORD

All Information Completely  
Required Affidavit  
or Deliver Report to  
Conservation Division  
State Corporation Comm.  
245 North Water  
Wichita, KS 67202

Ellis County, Sec. 15 Twp. 13S R. 20W  
Location as "NE/CNW/SW" or footage from lines  
W/2 SE NW  
Lease Owner J. R. Green  
Lease Name Johnson Well No. #2  
Office Address P.O. Box 503, Hays, Kansas 67601  
Character of Well (Completed as Oil, Gas or Dry Hole)  
Dry Hole

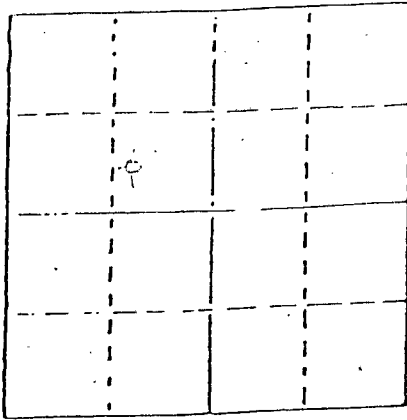

Date Well completed September 15, 1983  
Application for plugging filed September 15, 1983  
Application for plugging approved September 15, 1983  
Plugging commenced September 15, 1983  
Plugging completed September 15, 1983  
Reason for abandonment of well or producing formation  
Dry Hole

If a producing well is abandoned, date of last production  
N/A

Was permission obtained from the Conservation Division or  
its agents before plugging was commenced? Yes

Conservation Agent who supervised plugging of this well Gilbert Scheck  
Producing formation \_\_\_\_\_ Depth to top \_\_\_\_\_ Bottom \_\_\_\_\_ Total Depth of Well 3880'  
depth and thickness of all water, oil and gas formations.

L, GAS OR WATER RECORDS

CASING RECORD

FORMATION	CONTENT	FROM	TO	SIZE	PUT IN	PULLED OUT
Sand				8 5/8"	278'	none

Describe in detail the manner in which the well was plugged, indicating where the mud flu  
placed and the method or methods used in introducing it into the hold. If cement or oth  
were used, state the character of same and depth placed, from \_\_\_\_\_ feet to  
\_\_\_\_\_ feet for each plug set.

	3840'	20 SX
	1540'	20 SX
	700'	80 SX
	280'	40 SX
	40'	10 SX
	RH	10 SX

50 - 50 POZ 6% gel 3% ccl 7:15 PM

(If additional description is necessary, use BACK of this sheet)  
of Plugging Contractor Allied Cementing Company

OF Ellis COUNTY OF Kansas, ss.  
(employee of owner) or (owner or operator)  
above-described well, being first duly sworn on oath, says: That I have knowledge of  
facts, statements, and matters herein contained and the log of the above-described well  
is correct and that the same are true and correct. So help me God.


(Signature)

J. R. Green  
Box 503 Hays, Ks 67601  
(Address)

SUBSCRIBED AND SWORN TO before me this 19<sup>th</sup> day of October, 1983

Nicholas Niernberger  
Notary Public.

Commission expires 3-30-85

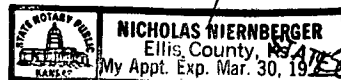

RECEIVED  
CORPORATION COMMISSION  
OCT 21 1983  
10-21-1983  
CONSERVATION DIVISION  
Wichita, Kansas