


WELL PLUGGING RECORD

Give All Information Completely  
Make Required Affidavit  
Mail or Deliver Report to:  
Conservation Division  
State Corporation Commission  
212 North Market, Insurance Bldg.  
Wichita, Kansas

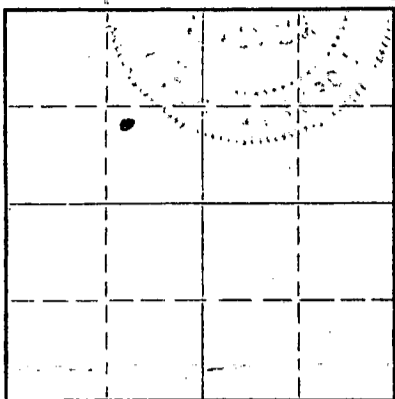

Locate well correctly on above Section Plat

ELLIS County. Sec. 15 Twp. 13S Rge. 20W (E) (W)  
Location as "NE/CNW/SW" or footage from lines. NW SE NW  
Lease Owner JOHN O. FARMER, INC.  
Lease Name JOHNSON Well No. 1  
Office Address P.O. Box 352, Russell, Kansas 67665  
Character of Well (completed as Oil, Gas or Dry Hole) Oil  
Date well completed August 21 1973  
Application for plugging filed June 20 1976  
Application for plugging approved June 29 1976  
Plugging commenced July 20 1976  
Plugging completed July 20 1976  
Reason for abandonment of well or producing formation Depleted

If a producing well is abandoned, date of last production September 1975  
Was permission obtained from the Conservation Division or its agents before plugging was commenced? Yes

Name of Conservation Agent who supervised plugging of this well Leo Massey  
Producing formation Topeka Depth to top 3243 Bottom 3247 Total Depth of Well 3877 Feet  
Show depth and thickness of all water, oil and gas formations.

OIL, GAS OR WATER RECORDS

CASING RECORD

FORMATION	CONTENT	FROM	TO	SIZE	PUT IN	PULLED OUT
Surface				8-5/8"	202'	None
Oil string				5-1/2"	3876'	None

Describe in detail the manner in which the well was plugged, indicating where the mud fluid was placed and the method or methods used in introducing it into the hole. If cement or other plugs were used, state the character of same and depth placed, from feet to feet for each plug set.

Pump in 25 sx. cement. Pump in 3 sx. cotton seed hulls and 25 sx. gel, 75 sx. cement.

RECEIVED  
STATE CORPORATION COMMISSION

MAR 23 1976  
07-23-1976  
CONSERVATION DIVISION  
Wichita, Kansas

(If additional description is necessary, use BACK of this sheet)  
Name of Plugging Contractor John O. Farmer, Inc.  
Address P.O. Box 352, Russell, Kansas 67665

STATE OF KANSAS, COUNTY OF RUSSELL, ss.  
HAROLD A. CARLSON (employee of owner) or (owner or operator) of the above-described well, being first duly sworn on oath, says: That I have knowledge of the facts, statements, and matters herein contained and the log of the above-described well as filed and that the same are true and correct. So help me God.

(Signature) Harold A. Carlson  
P.O. Box 652 (Address)

Subscribed and sworn to before me this 22nd day of July, 1976

My commission expires February 15, 1979



Helen Carlson  
Notary Public.

15-051-20909-00-00

DRILLERS LOG

JOHNSTON #1

CASING RECORD:	OPERATOR: John O. Farmer, Inc.	DESCRIPTION:
202' w/8-5/8" w/ 150 sacks cement	CONTRACTOR: John O. Farmer, Inc.	NW SE-NW Sec. 15-13S-20W Ellis County, Kansas
TOTAL DEPTH: 3877'	COMMENCED: July 25, 1973	ELEVATION: 2178'KB
	COMPLETED: August 3, 1973	

<u>FORMATION</u>	<u>FROM</u>	<u>TO</u>
Shale	202	575
Sand & Shale	575	1100
Sand	1100	1230
Red bed	1230	1527
Anhydrite	1527	1568
Shale & Shells	1568	2140
Shale & Lime	2130	3520
Lime	3520	3838
Arbuckle	3838	3877
Total Depth	3877'	


Run 5 1/2" casing @  
3876' w/160 sx cemen  
Completed 7:00 p.m.

I certify that this is a true and correct copy of the above log to the best of my knowledge.

JOHN O. FARMER, INC.

By John O. Farmer

Subscribed and sworn to before me this 8th day of August, 1973.

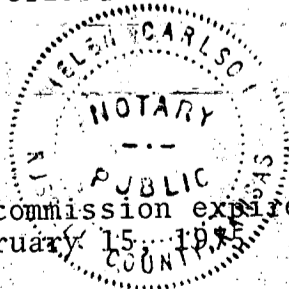

My commission expires:  
February 15, 1975

Helen Carlson  
Helen Carlson

RECEIVED  
STATE CORPORATION COMMISSION

JUN 29 1976  
06-29-1976  
CONSERVATION DIVISION  
Wichita, Kansas