

STATE OF KANSAS
STATE CORPORATION COMMISSION

WELL PLUGGING RECORD

Give All Information Completely
Make Required Affidavit
Mail or Deliver Report to:
Conservation Division
State Corporation Commission
800 Bitting Building
Wichita, Kansas

OR

Strike out upper line
when reporting plug-
ging of formations.

FORMATION PLUGGING RECORD

Sedgwick County. Sec. 17 Twp. 28 Rge. 1 (E) (W)

Location as "NE $\frac{1}{4}$ NW $\frac{1}{4}$ SW $\frac{1}{4}$ " or footage from lines SW $\frac{1}{4}$ NE $\frac{1}{4}$ SE 1/4

Lease Owner E.B. Shawver

Lease Name Zimmerman Well No. 1

Office Address Wichita, Kansas

Character of Well (completed as Oil, Gas or Dry Hole) Dry hole

Date well completed April 24, 1950 19.

Application for plugging filed April 25, 1950 19.

Application for plugging approved April 26, 1950 19.


Plugging commenced April 26, 1950 19.

Plugging completed April 28, 1950 19.

Reason for abandonment of well or producing formation

If a producing well is abandoned, date of last production 19.

Was permission obtained from the Conservation Division or its agents before plugging was com-
menced? yes

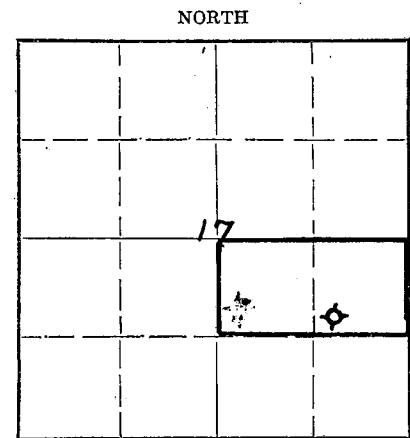

Locate well correctly on above
Section Plat

Name of Conservation Agent who supervised plugging of this well Mr. Lilly

Producing formation Chat Depth to top 3071' Bottom 3101 Total Depth of Well 3119 Feet

Show depth and thickness of all water, oil and gas formations.

OIL, GAS OR WATER RECORDS

CASING RECORD

Formation	Content	From	To	Size	Put In	Pulled Out
Chat	Dry	3071'	3119	5 1/8"	3071	2833' 4"
				8 5/8"	89'	None
(The above are rotary bushing measurements)						

Describe in detail the manner in which the well was plugged, indicating where the mud fluid was placed and the method or methods used in introducing it into the hole. If cement or other plugs were used, state the character of same and depth placed, from _____ feet to _____ feet for each plug set.

The above well was filled with cement from 3119' to 3051 then mud to 125' then rock to 115' then cement to 55' then mud to 12' then cement to 3' to top of surface pipe

05-11-50
MAY 11 1950
DIVISION
KANSAS

(If additional description is necessary, use BACK of this sheet)

Correspondence regarding this well should be addressed to E.B. Shawver
Address 310 Petroleum Bldg. Wichita, Kansas

STATE OF KANSAS, COUNTY OF SEDGWICK, ss.

Sampson D. Batz (employee of owner) or (owner or operator) of the above-described well,
being first duly sworn on oath, says: That I have knowledge of the facts, statements, and matters herein contained and the log of the above-described well as filed and that the same are true and correct. So help me God.

(Signature) S D Batz


Route 6, Wichita, Kansas (Address)

SUBSCRIBED AND SWORN to before me this 10th day of May, 1950.

My commission expires December 16, 1953

Amy Jones Notary Public.

22-2625 -2-48-15M
PLUGGING
FILE SEC 17-T-28-R-1E
DOCK PAGE 2 LINE 36

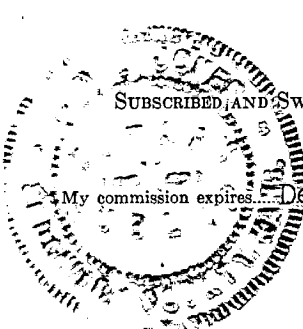

LOG

H. ZIMMERMAN et al No. 1, N/2 SE/4 Sec. 17-28S-1E, Sedgwick County
 Location: 1100' W of EL & 320' N of SL, NE/4 SE/4 of Section 17

Owner: E. B. Shawver et al Drilling commenced April 2, 1950
 Contractor: do Drilling completed April 22, 1950

89' 8-5/8" cemented w/80 sax
 3081' 5 1/2" " w/35 sax Elevation: 1275'

sand	42
shale	75
lime	570
shale & shells	1565
lime	1695
shale	1715
lime	1775
shale	1850
lime	2120
lime sandy	2125
shale	2585
K.C. lime	2770
shale	3069
corrected to DP	
measurement	3069=3067
chert & lime	3117 TD

plugged back to 3100
 & acidized with 2,000 gal.

Before acid: 1/2 bailer oil in hole
 After acid: 2 bailers oil in hole

D & A

