

STATE OF KANSAS  
STATE CORPORATION COMMISSION


Give All Information Completely  
Make Required Affidavit  
Mail or Deliver Report to:  
Conservation Division  
State Corporation Commission  
211 No. Broadway  
Wichita, Kansas

WELL PLUGGING RECORD

Sedgwick County, Sec. 17 Twp. 28 Rge. 1 (E) (W)

Location as "NE/CNW/SW" or footage from lines SE SE SE  
Lease Owner Stelbar Oil Corporation  
Lease Name Clara Russell Well No. 1  
Office Address 310 Petroleum Bldg., Wichita, Kansas  
Character of Well (completed as Oil, Gas or Dry Hole) oil well  
Date well completed 7-30-34 19  
Application for plugging filed 12-9-65 19  
Application for plugging approved 12-10-65 19  
Plugging commenced 12-15-65 19  
Plugging completed 12-17-65 19  
Reason for abandonment of well or producing formation depleted

NORTH

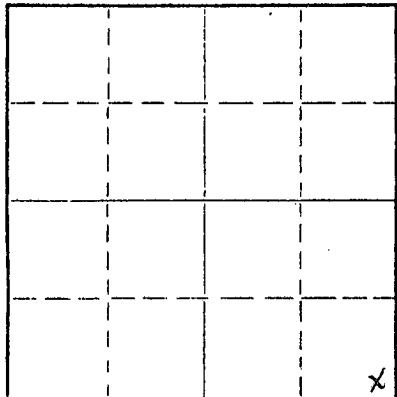

Locate well correctly on above  
Section Plat

If a producing well is abandoned, date of last production 19  
Was permission obtained from the Conservation Division or its agents before plugging was commenced? yes

Name of Conservation Agent who supervised plugging of this well Paul Turpin  
Producing formation Depth to top Bottom Total Depth of Well 3140 Feet  
Show depth and thickness of all water, oil and gas formations.

OIL, GAS OR WATER RECORDS

CASING RECORD

FORMATION	CONTENT	FROM	TO	SIZE	PUT IN	PULLED OUT
				15 1/2	54	none
				7	3065	2094

Describe in detail the manner in which the well was plugged, indicating where the mud fluid was placed and the method or methods used in introducing it into the hole. If cement or other plugs were used, state the character of same and depth placed, from feet to feet for each plug set.

Fill hole with sand from 3140' to 3050' and dump 5 sacks cement.  
Set 20' rock bridge from 190' to 170' and dump 8 cubic yards of  
ready mix concrete

RECEIVED  
STATE CORPORATION COMMISSION

DEC 27 1965

12-27-65  
CONSERVATION DIVISION  
Wichita, Kansas

(If additional description is necessary, use BACK of this sheet)  
Name of Plugging Contractor Flint Engineering & Construction Company  
Address Box 950, El Dorado, Kansas

STATE OF KANSAS, COUNTY OF BUTLER, ss.

(employee of owner) or (owner or operator) of the above-described well, being first duly sworn on oath, says: That I have knowledge of the facts, statements, and matters herein contained and the log of the above-described well as filed and that the same are true and correct. So help me God.

(Signature) James Bawelle  
El Dorado, Kansas

SUBSCRIBED AND SWORN to before me this 22nd day of December 19 65

My commission expires 9-27-67 Ronald L. Hanson  
Notary Public.



15-173-03142-0000

E. B. Shawver, Aladdin and Lodo Oil Company

RECORD of WELL No. 1 Clara Russell Farm

Location Sec S $\frac{1}{2}$  SE $\frac{1}{4}$  Sec. 17 Twp. 28S Rge 1 E

Sedgwick County, Kansas

Rig Commenced \_\_\_\_\_ Rig Completed \_\_\_\_\_

Rig Contractor R. W. Sage

Drilling Commenced June 16, 1934 Drilling Completed July 30, 1934

Contractor E. B. Shawver Price per foot \$ \_\_\_\_\_

CASING AND TUBING RECORD—						
SIZE	FEET	MAKE	SIZE	FEET	MAKE	
Conductor			0 1/2 in.	lb.	2853-UR	3065
15 1/4 in.	70 lb.	54	5 1/2 in.	lb.		
12 1/2 in.	54 lb.	1475	2 1/2" Tubing	lb.	3104	17" (threads off)
10 in.	lb.	1916-UR				21' of anchor
		1979				10' barrel
8 1/4 in.	lb.	2355				4' tubing catcher-set

NAME OF SANDS	TOP	BOTTOM	FEET OF SAND	REMARKS
				Water-Record:
				1/2 BWPB 600-700
				5 BWPB 1200
				HFW 1450
				4 BW 1500
				HFW 1814
				HFW 2530
				1 1/2 BWPB 2630
				3 1/2 BW 2650-60
TOTAL DEPTH				

Record of Sand and Oil Showing First gas 3070-71. First oil 3084.

Production first 24 hours 30 bbls. first hour: 34 bbls. second hr. Gravity  
Averaged 494 barrels of oil daily on 3 day potential test 7/31-8/3/34  
Details of Shot Treated with 1000 gallons of acid on August 4, 1934.  
Averaged 661 bbls. per day on 3 day potential test after acidizing.  
 Recorded by \_\_\_\_\_

SUBSEQUENT HISTORY	TORPEDOED	
	QUARTS	DATE RE-SHOT