

STATE OF KANSAS  
STATE CORPORATION COMMISSION

WELL PLUGGING RECORD

Give All Information Completely  
Make Required Affidavit  
Mail or Deliver Report to:  
Conservation Division  
State Corporation Commission  
211 No. Broadway  
Wichita, Kansas

Sedgwick County. Sec. 17 Twp. 28 Rge. 1 (E) (W)

Location as "NE/CNW/SW" or footage from lines NE SE SE

Lease Owner Stelbar Oil Corporation

Lease Name Clara Russell Well No. 4

Office Address 310 Petroleum Bldg., Wichita, Kansas

Character of Well (completed as Oil, Gas or Dry Hole) oil well

Date well completed 11-26-34 19  

Application for plugging filed 10-9-65 19  

Application for plugging approved 12-10-65 19  


Plugging commenced 12-13-65 19  

Plugging completed 12-14-65 19  

Reason for abandonment of well or producing formation depleted

If a producing well is abandoned, date of last production    19  

Was permission obtained from the Conservation Division or its agents before plugging was commenced? yes

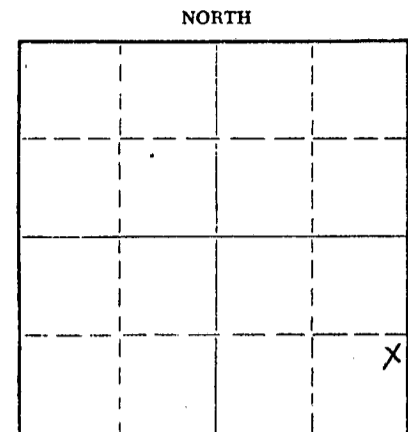

Locate well correctly on above  
Section Plat

Name of Conservation Agent who supervised plugging of this well Paul Turpin

Producing formation    Depth to top    Bottom    Total Depth of Well 3085 Feet

Show depth and thickness of all water, oil and gas formations.

OIL, GAS OR WATER RECORDS

CASING RECORD

| FORMATION | CONTENT | FROM | TO | SIZE | PUT IN | PULLED OUT |
|-----------|---------|------|----|------|--------|------------|
|           |         |      |    | 10   | 91     | none       |
|           |         |      |    | 7    | 3074   | 2341       |
|           |         |      |    |      |        |            |
|           |         |      |    |      |        |            |
Describe in detail the manner in which the well was plugged, indicating where the mud fluid was placed and the method or methods used in introducing it into the hole. If cement or other plugs were used, state the character of same and depth placed, from    feet to    feet for each plug set.

Fill hole with sand from 3085' to 3065' and dump 5 sacks cement.  
Set 15' rock bridge from 180' to 165' add dump 3 cubic yards of  
ready mix to bottom of cellar

RECEIVED  
STATE CORPORATION COMMISSION

DEC 27 1965  
12-27-65

CONSERVATION DIVISION  
Wichita, Kansas

Name of Plugging Contractor Flint Engineering & Construction Company  
Address Box 950, El Dorado, Kansas

STATE OF KANSAS, COUNTY OF BUTLER, ss.     
   (employee of owner) or (owner or operator) of the above-described well, being first duly sworn on oath, says: That I have knowledge of the facts, statements, and matters herein contained and the log of the above-described well as filed and that the same are true and correct. So help me God.

(Signature) Clara Russell

El Dorado, Kansas  
(Address)

SUBSCRIBED AND SWORN to before me this 22nd day of December, 1965

9-27-67

Ronald K. Hansen  
Notary Public.



