


Give All Information Completely
Make Required Affidavit
Mail or Deliver Report to:
Conservation Division
State Corporation Commission
800 Bittling Building
Wichita, Kansas

WELL PLUGGING RECORD

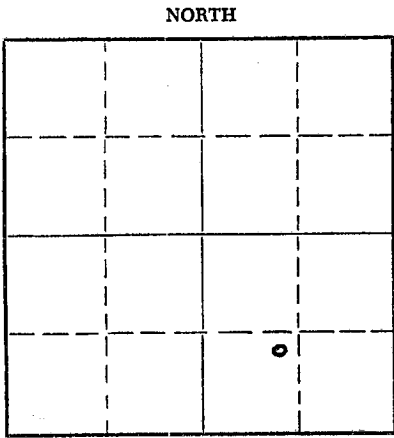

Locate well correctly on above
Section Flat

Pratt County. Sec. 12 Twp. 27 Rge. 11 (X) (W)
Location as "NE/CNW/SW" or footage from lines NE SW SE
Lease Owner D & M Drilling Company, Inc.
Lease Name G. Cannon #1 Well No. 1
Office Address 809 Union Center, Wichita, Kansas
Character of Well (completed as Oil, Gas or Dry Hole) Dry Hole
Date well completed November 5, 1959
Application for plugging filed November 5, 1959
Application for plugging approved -November 5, 1959
Plugging commenced November 5, 1959
Plugging completed November 5, 1959
Reason for abandonment of well or producing formation _____

If a producing well is abandoned, date of last production None 19____
Was permission obtained from the Conservation Division or its agents before plugging was commenced? Yes

Name of Conservation Agent who supervised plugging of this well Frank Broadfoot
Producing formation _____ Depth to top 4410 Bottom _____ Total Depth of Well _____ Feet
Show depth and thickness of all water, oil and gas formations.

OIL, GAS OR WATER RECORDS

CASING RECORD

FORMATION	CONTENT	FROM	TO	SIZE	PUT IN	PULLED OUT
Sand & Shale		0'	292'	8 5/8"	292'	0'
DRILLERS LOG HEREWITH					Cemented w/138 Sks.	
					Cement circulated	

Describe in detail the manner in which the well was plugged, indicating where the mud fluid was placed and the method or methods used in introducing it into the hole. If cement or other plugs were used, state the character of same and depth placed, from _____ feet to _____ feet for each plug set.

Heavy mud from TD to 240', Set Halliburton plug, 1/2 sks hulls, 20 sks cement.
Fill with heavy mud to 35', set Halliburton plug 1/2 sk hulls, 10 sks cement.

RECEIVED
STATE CORPORATION COMMISSION
NOV 16 1959 11-16-59
CONSERVATION DIVISION
Wichita, Kansas

(If additional description is necessary, use BACK of this sheet)
Name of Plugging Contractor S & S Drilling Company
Address Box 194, Great Bend, Kansas

STATE OF KANSAS, COUNTY OF SEDGWICK, ss.
_____, (employee of owner) or (owner or operator) of the above-described well, being first duly sworn on oath, says: That I have knowledge of the facts, statements, and matters herein contained and the log of the above-described well as filed and that the same are true and correct. So help me God.

(Signature) Don S. Packer
809 Union Center, Wichita, Kansas
(Address)

SUBSCRIBED AND SWORN to before me this 6th day of November, 1959

Helen Y. Langston
Helen Y. Langston
Notary Public.

My commission expires March 26, 1963

15-151-00260-5000

WELL LOG
Gertrude Cannon # 1
NE/4 SW/4 SE/4 12-275-11W
Pratt County, Kansas

12 27 11
12 SW 54
Victoria, Kansas

Elevation 1766 D.F.

0 - 292	Sand & Shale	Formation Tops:	
292 - 760	Sand, Shale, Red Bed	Heebner	3398
760 - 900	Red Bed & Shale	Douglas	3428
900 - 1125	Shale	Kansas City	3589
1125 - 1300	Salt	Mississippi	4057
1300 - 1500	Shale & Shells	Kinderhook	4126
1500 - 1960	Lime & Shale	Viola	4287
1960 - 2780	Shale & Lime	Simpson	4380
2780 - 3620	Lime & Shale		
3620 - 3752	Lime		
3752 - 3835	Lime & Shale		
3835 - 3885	Lime		
3885 - 4070	Lime & Shale		
4070 - 4123	Lime		
4123 - 4287	Shale & Lime		
4287 - 4380	Lime (Viola)		
4380 - 4410	Shale, Sand		
4410	R. T. D.		

RECEIVED
STATE CORPORATION COMMISSION
NOV 16 1959
CONSERVATION DIVISION
Wichita, Kansas


STATE OF KANSAS

COUNTY OF PRATT ss

T. D. Sweetman, partner of S & S Drilling Company, being first duly sworn on oath says: That I have knowledge of the facts, statements and matters herein contained and the log of the above described well as filed and that the same are true and correct.

T. D. Sweetman
T. D. Sweetman

Subscribed and sworn before me this 5th day of November, 1959.

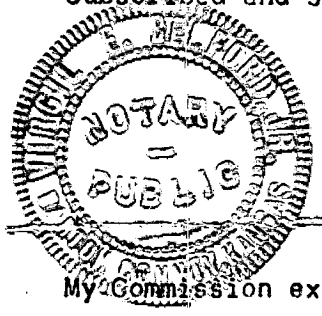

Virginia E. MacLean
Notary Public, Barton County

My Commission expires April 27, 1961