


STATE OF KANSAS
STATE CORPORATION COMMISSION

WELL PLUGGING RECORD

Give All Information Completely
Make Required Affidavit
Mail or Deliver Report to
Conservation Division
State Corporation Comm.
245 North Water
Wichita, KS 67202

Pratt County. Sec. 12 Twp. 27S Rge. 11W ~~EXW~~
Location as "NE/CNW $\frac{1}{4}$ /SW $\frac{1}{4}$ " or footage from lines _____
C NW SE
Lease Owner Hummon Oil Company
Lease Name Conley Well No. 1
Office Address 1725 Vickers-KSB&T Bldg., Wichita, Ks.
Character of Well (Completed as Oil, Gas or Dry Hole) _____

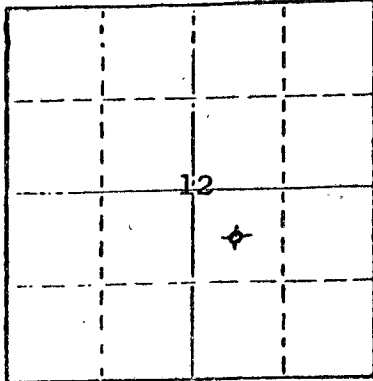

Locate well correctly on above
Section Plat

Dry Hole
Date Well completed November 24, 1978
Application for plugging filed November 24, 1978
Application for plugging approved November 24, 1978
Plugging commenced November 24, 1978
Plugging completed November 24, 1978
Reason for abandonment of well or producing formation _____

Dry Hole
If a producing well is abandoned, date of last production _____
19 _____

Was permission obtained from the Conservation Division or
its agents before plugging was commenced? Yes

Name of Conservation Agent who supervised plugging of this well Wm. T. Owen
Producing formation _____ Depth to top _____ Bottom _____ Total Depth of Well 4348'
Show depth and thickness of all water, oil and gas formations.

OIL, GAS OR WATER RECORDS

CASING RECORD

FORMATION	CONTENT	FROM	TO	SIZE	PUT IN	PULLED OUT
		0'	339'	8-5/8"	332.14'	None

Describe in detail the manner in which the well was plugged, indicating where the mud fluid
was placed and the method or methods used in introducing it into the hold. If cement or other
plugs were used, state the character of same and depth placed, from _____ feet to
_____ feet for each plug set.

Plugged with 50 sacks cement at 600',
40 sacks cement at 330', plug and
1/2 sack hulls at 40',

RECEIVED
STATE CORPORATION COMMISSION
DEC - 4 1978

(If additional description is necessary, use BACK of this report)
Name of Plugging Contractor Allied Cementing Co.

CONSERVATION DIVISION
Wichita, Kansas
12-04-78

STATE OF KANSAS COUNTY OF SEDGWICK, ss.
John D. Knightley, Agent (employee of owner) or (owner or operator)
of the above-described well, being first duly sworn on oath, says: That I have knowledge of
the facts, statements, and matters herein contained and the log of the above-described well
as filed and that the same are true and correct. So help me God.

(Signature) [Signature]
221 S. Broadway, Wichita, Kansas
(Address)

My commission expires March 12, 1979

[Signature]
Notary Public.



Hummon Oil Company - Conley #1
 C NW SE Sec. 12-27S-11W
 Pratt County, Kansas

Contractor: D. R. Lauck Oil Company, Inc.
 221 S. Broadway, Suite 400
 Wichita, Kansas 67202

Commenced: November 14, 1978
 Completed: November 24, 1978

Drillers Log

Sand	162
Red Bed	835
Shale	1650
Shale & Shells	2750
Shale & Lime	3130
Shale & Shells	3325
Shale & Lime	3635
Lime	3780
Lime & Shale	3795
Lime	4348 RTD

RECEIVED
 STATE CORPORATION COMMISSION

DEC - 4 1978

CONSERVATION DIVISION
 Wichita, Kansas