

STATE OF KANSAS  
STATE CORPORATION COMMISSION

Form CP-4

WELL PLUGGING RECORD

Give All Information Completely  
Make Required Affidavit  
Mail or Deliver Report to:  
Conservation Division  
State Corporation Commission  
212 No. Market  
Wichita, Kansas

Trego County. Sec. 2 Twp. 13S Rge. (X) 21 (W)

Location as "NE/CNW/SW" or footage from lines NE SW SE

Lease Owner Rains & Williamson Oil Co., Inc.

Lease Name DEUTSCHER Well No. 1

Office Address 1425 Wichita Plaza - Wichita, Kansas

Character of Well (completed as Oil, Gas or Dry Hole) Dry Hole

Date well completed 2-23 19 67

Application for plugging filed 2-23 19 67

Application for plugging approved 2-23 19 67


Plugging commenced 2-23 19 67

Plugging completed 2-23 19 67

Reason for abandonment of well or producing formation No oil or gas found  
in commercial quantities.

If a producing well is abandoned, date of last production -- 19 --

Was permission obtained from the Conservation Division or its agents before plugging was commenced? Yes

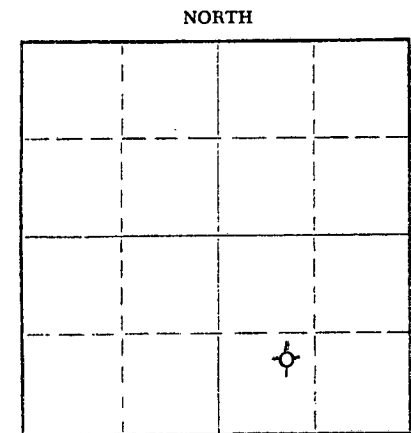

Locate well correctly on above Section Plat

Name of Conservation Agent who supervised plugging of this well Bill Nichols, Moreland, Kansas

Producing formation None Depth to top -- Bottom -- Total Depth of Well 3850 Feet

Show depth and thickness of all water, oil and gas formations.

OIL, GAS OR WATER RECORDS

CASING RECORD

FORMATION	CONTENT	FROM	TO	SIZE	PUT IN	PULLED OUT
				8-5/8"	213.23'	-0-

Describe in detail the manner in which the well was plugged, indicating where the mud fluid was placed and the method or methods used in introducing it into the hole. If cement or other plugs were used, state the character of same and depth placed, from \_\_\_\_\_ feet to \_\_\_\_\_ feet for each plug set.

Pushed plug and hulls to 540'. Cemented through  
drill pipe with 20 sacks. Mud back to 210', set solid  
bridge and capped with 10 sacks; 2 sacks in rat hole.  
Plugging completed at 6:00 A.M., 2-23-67

RECEIVED  
STATE CORPORATION COM.

FEB 28 1967

02-28-67

CONSERVATION DIVISION  
Wichita, Kansas

(If additional description is necessary, use BACK of this sheet)

Name of Plugging Contractor Rains & Williamson Oil Co., Inc.

Address 1425 Wichita Plaza - Wichita, Kansas

STATE OF KANSAS, COUNTY OF SEDGWICK, ss.  
Wilson Rains

(employee of owner) or (owner or operator) of the above-described well, being first duly sworn on oath, says: That I have knowledge of the facts, statements, and matters herein contained and the log of the above-described well as filed and that the same are true and correct. So help me God.

(Signature) Wilson Rains Wilson Rains  
1425 Wichita Plaza - Wichita, Kansas  
(Address)

SUBSCRIBED and sworn to before me this 27 day of February, 19 67

Mary J. Brown  
Mary J. Brown Notary Public.

My commission expires March 3, 1970



ROTARY DRILLING LOG

Operator: Rains & Williamson Oil Co., Inc.  
#1 DEUTSCHER  
NE SW SE Section 2-13S-21W  
Trego County, Kansas

Contractor: Rains & Williamson Oil Co., Inc.

Commenced: 2-15-67  
Completed: 2-23-67

Remarks: Set 8-5/8" surface casing at 213.23' with 160 sacks GL-3 cement.

FORMATIONS:

Surface clay and Sand	105'
Shale	1025'
Sand	1242'
Shale	1528'
Anhydrite	1576'
Shale	2195'
Shale and Lime	2370'
Lime and Shale	2650'
Shale and Lime	2900'
Lime and Shale	3485'
Lime	3755'
Lime and Chert	3793'
Lime	3850'
Rotary Total Depth (D & A)	3850'


RECEIVED  
STATE CORPORATION COMMISSION  
FEB 28 1967  
CONSERVATION DIVISION  
Wichita, Kansas

We certify the above log is true and correct to the best of our knowledge and belief.

RAINS & WILLIAMSON OIL CO., INC.

*Wilson Rains*  
Wilson Rains

Subscribed and sworn to before me, a Notary Public in and for the State of Kansas, County of Sedgwick, this 27th day of February, 1967.

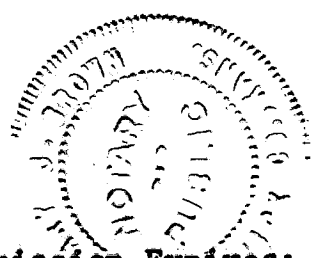

*Mary J. Brown*  
Mary J. Brown Notary Public

My Commission Expires:  
March 3, 1970