

STATE OF KANSAS
STATE CORPORATION COMMISSION

WELL PLUGGING RECORD

Give All Information Completely
Make Required Affidavit
Mail or Deliver Report to
Conservation Division
State Corporation Comm.
245 North Water
Wichita, KS 67202

Trego County, Sec. 2 Twp. 13S Rge. 21 E/W
Location as "NE/CNW/SW" or footage from lines

Lease Owner Euwer Petroleum Company
Lease Name Helget Well No. #1

Office Address 110 N. Market, Wichita, Kans. 67202
Character of Well (Completed as Oil, Gas or Dry Hole)


Dry Hole

Date Well completed 10-20-78 19
Application for plugging filed 10-20-78 19
Application for plugging approved 10-20-78 19
Plugging commenced 10-20-78 19
Plugging completed 10-20-78 19

Reason for abandonment of well or producing formation
Commercial quantities of oil not found
If a producing well is abandoned, date of last production 19

Was permission obtained from the Conservation Division or its agents before plugging was commenced? Yes

Name of Conservation Agent who supervised plugging of this well Gilbert Balthazor, Palco, Ks.
Producing formation Depth to top Bottom Total Depth of Well 3896'
Show depth and thickness of all water, oil and gas formations.

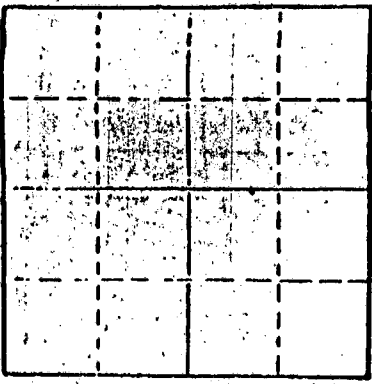

Locate well correctly on above Section Plot

OIL, GAS OR WATER RECORDS

CASING RECORD

FORMATION	CONTENT	FROM	TO	SIZE	PUT IN	PULLED OUT
				8 5/8"	250.57'	None

Describe in detail the manner in which the well was plugged, indicating where the mud fluid was placed and the method or methods used in introducing it into the hold. If cement or other plugs were used, state the character of same and depth placed, from feet to feet for each plug set.

Plug @ 600' w/70 sx.
Plug @ 240' w/20 sx.
Plug @ 40' w/10 sx.
Rat Hole 2 sx.


(If additional description is necessary, use BACK of this sheet)

Name of Plugging Contractor Rains & Williamson Oil Co., Inc.

STATE OF Kansas COUNTY OF Sedgwick, ss.
Wilson Rains, President of Rains & Williamson Oil Co., Inc. (employee of owner) or (owner or operator) of the above-described well, being first duly sworn on oath, says: That I have knowledge of the facts, statements, and matters herein contained and the log of the above-described well as filed and that the same are true and correct. So help me God.

(Signature) Wilson Rains
435 Page Court, 220 W. Douglas, Wichita, Ks. 67202
(Address)

SUBSCRIBED AND SWORN TO before me this 23 day of October, 1978

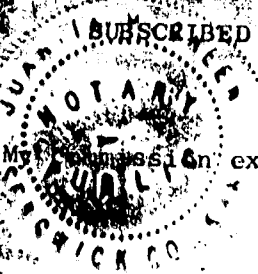

Juanita M. Green
Notary Public.
STATE CORPORATION COMMISSION

My Commission expires 10-4-79

NOV - 1 1978

CONSERVATION DIVISION
Wichita, Kansas

15-195-20498-00-00

DRILLER'S LOG

COMPANY: Euwer Petroleum Company

SEC. 2 T. 13S R. 21W

LOC. NW SW NW

WELL NAME: Helget #1

COUNTY: Trego

RIG NO. #4

TOTAL DEPTH 3896'

ELEVATION

COMMENCED: 10-6-78

COMPLETED: 10-20-78

CONTRACTOR: Rains & Williamson Oil Co., Inc.

CASING RECORD:

SURFACE: 8 5/8" @ 250.57' w/200 sx. 50/50 poz., 2% gel, 3% cc.

PRODUCTION: D&A

LOG

(Figures Indicate Bottom of Formations)

Clay	150
Clay, Sand & Shale	260
Shale	1040
Sand	1265
Shale & Redbed	1375
Redbed & Shale	1558
Shale	1596
Shale & Redbed	1755
Shale	3110
Shale & Lime	3265
Lime	3660
Lime & Shale	3698
Shale & Lime	3770
Lime	3830
Lime & Shale	3860
Lime	3896
<u>ROTARY TOTAL DEPTH</u>	<u>3896</u>

RECEIVED
STATE CORPORATION COMMISSION

NOV - 1 1978

CONSERVATION DIVISION
Wichita, Kansas

STATE OF Kansas)
COUNTY OF Sedgwick) SS:

I, Wilson Rains, President of Rains & Williamson Oil Co., Inc.
upon oath state that the above and foregoing is a true and correct copy of the log of the
Helget #1 well.

Wilson Rains
Wilson Rains



Subscribed and sworn to before me this 23 day of October, 1978.

My Appointment Expires:
10-4-79

Juanita M. Green
Juanita M. Green