

STATE OF KANSAS
STATE CORPORATION COMMISSION

15-051-22282-00-00

15-051-22282-00-00
WELL PLUGGING RECORD

Give All Information Completely
Make Required Affidavit
Mail or Deliver Report to
Conservation Division
State Corporation Comm.
245 North Water
Wichita, KS 67202

Ellis County, Sec. 16 Twp. 13 Rge. 18 X/W
Location as "NE/CNW $\frac{1}{2}$ SW $\frac{1}{2}$ " or footage from lines

100' N NE SE SE
Lease Owner T & D Oil Co.

Lease Name Leiker Well No. 1

Office Address Victoria, KS 67671

Character of Well (Completed as Oil, Gas or Dry Hole)

Dry Hole

Date Well completed 2-9 19 81

Application for plugging filed 2-9 19 81

Application for plugging approved 2-9 19 81

Plugging commenced 2-9 19 81

Plugging completed 2-9 19 81

Reason for abandonment of well or producing formation


If a producing well is abandoned, date of last production 19

Was permission obtained from the Conservation Division or its agents before plugging was commenced? Yes

Name of Conservation Agent who supervised plugging of this well Marion Schmidt

Producing formation Depth to top Bottom Total Depth of Well 3730'

Show depth and thickness of all water, oil and gas formations.

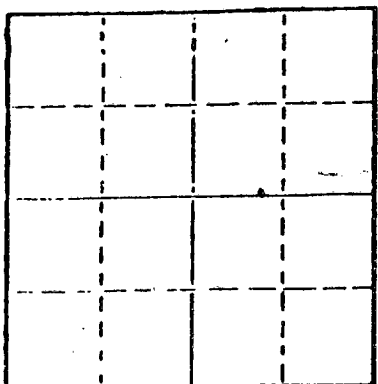

Locate well correctly on above Section Plot

OIL, GAS OR WATER RECORDS

CASING RECORD

FORMATION	CONTENT	FROM	TO	SIZE	PUT IN	PULLED OUT
				8 5/8"	491'	-0-

Describe in detail the manner in which the well was plugged, indicating where the mud fluid was placed and the method or methods used in introducing it into the hold. If cement or other plugs were used, state the character of same and depth placed, from feet to feet for each plug set.

- 1st plug was set @ 685' with 65 sacks cement
- 2nd plug was set @ 300' with 30 sacks cement
- 3rd plug was set @ 40' with 10 sacks cement

(If additional description is necessary, use BACK of this sheet)

Name of Plugging Contractor Dreiling Oil, Inc., Victoria, KS 67671

STATE OF KANSAS COUNTY OF ELLIS, ss.

I, Joseph A. Hess, Sec.-Treas. of Drlg. Contrc. (employee of owner) or (owner or operator) of the above-described well, being first duly sworn on oath, says: That I have knowledge of the facts, statements, and matters herein contained and the log of the above-described well as filed and that the same are true and correct. So help me God.

(Signature) *Joseph A. Hess*

JOSEPH A. HESS, Hays, KS 67601
(Address)

SUBSCRIBED AND SWORN TO before me this 17th day of February, 19 81

Patty Dreiling
Patty Dreiling Notary Public.

My commission expires August 30, 1982



RECEIVED
STATE CORPORATION COMMISSION

FEB 18 1981
2-18-81
CONSERVATION DIVISION
Wichita, Kansas