

STATE OF KANSAS
STATE CORPORATION COMMISSION


Give All Information Completely
Make Required Affidavit
Mail or Deliver Report to:
Conservation Division
State Corporation Commission
211 No. Broadway
Wichita, Kansas

15-051-20218-00-00 Form CP-4
15-051-20218-00-00
WELL PLUGGING RECORD

Ellis County, Sec. 8 Twp. 13S Rge. 18W (E) (W)

Location as "NE/CNWxSWx" or footage from lines SE NE SW
Lease Owner Kern Drilling Company, Inc.
Lease Name Knoll Well No. 1
Office Address Box 688, Magnolia, Arkansas 71753
Character of Well (completed as Oil, Gas or Dry Hole) Dry Hole
Date well completed March 11 19 68
Application for plugging filed March 11 19 68
Application for plugging approved March 11 19 68
Plugging commenced March 11 19 68
Plugging completed March 11 19 68
Reason for abandonment of well or producing formation Dry Hole

NORTH

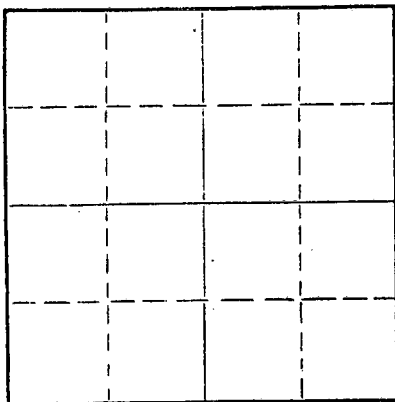

Locate well correctly on above Section Plat

If a producing well is abandoned, date of last production _____ 19____
Was permission obtained from the Conservation Division or its agents before plugging was commenced? Yes

Name of Conservation Agent who supervised plugging of this well Leo Massey, Box 582, Hays, Kansas
Producing formation _____ Depth to top _____ Bottom _____ Total Depth of Well 3432 Feet
Show depth and thickness of all water, oil and gas formations.

OIL, GAS OR WATER RECORDS

CASING RECORD

FORMATION	CONTENT	FROM	TO	SIZE	PUT IN	PULLED OUT
				8-5/8"	520	

Describe in detail the manner in which the well was plugged, indicating where the mud fluid was placed and the method or methods used in introducing it into the hole. If cement or other plugs were used, state the character of same and depth placed, from _____ feet to _____ feet for each plug set.

Plug: 680' w/60 sacks cement
40' w/10 sacks cement

RECEIVED
STATE CORPORATION COMMISSION
3-20-68
MAR 20 1968
CONSERVATION DIVISION
Wichita, Kansas


(If additional description is necessary, use BACK of this sheet)

Name of Plugging Contractor Hellar Drilling Company, Inc.
Address 1014 Union Center, Wichita, Kansas

STATE OF KANSAS COUNTY OF SEDGWICK, ss.
D. L. Hellar, President of Hellar Drilling Company, Inc. (employee of owner) or (owner or operator) of the above-described well, being first duly sworn on oath, says: That I have knowledge of the facts, statements, and matters herein contained and the log of the above-described well as filed and that the same are true and correct. So help me God.

(Signature) D. L. Hellar D. L. Hellar, President
1014 Union Center, Wichita, Kansas
(Address)

SUBSCRIBED AND SWORN TO before me this 19th day of March, 19 78

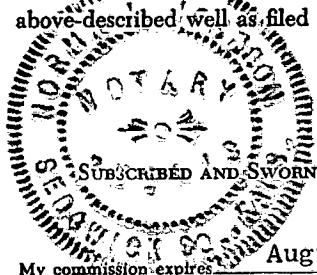

Norma J. Johnson
Notary Public.

My commission expires August 2, 1970

DRILLER'S LOG

COMPANY: Kern Drilling Company, Inc., Magnolia, Arkansas
CONTRACTOR: Hellar Drilling Company, Inc., Wichita, Kansas
LEASE: Knoll #1
LOCATION: SE NE SW Section 8-13S-18W
Ellis County, Kansas
COMMENCED: March 6, 1968
COMPLETED: March 11, 1968
CASING: Set 8-5/8" surface casing at 520' w/310 sacks

15-051-20218-00-00
15-051-20218-00-00

0 - 1415 Sand and shale
1415 - 1442 Shale and Red Bed
1442 - 1486 Anhydrite
1486 - 1680 Shale and Red Bed
1680 - 2040 Shale and salt section
2040 - 2270 Salt section & Ft. Riley
2270 - 3432 Lime and shale
3432 Total Depth

D & A

RECEIVED
STATE CORPORATION COMMISSION
MAR 20 1968
CONSERVATION DIVISION
Wichita, Kansas

STATE OF KANSAS)
) SS
COUNTY OF SEDGWICK)

I, D. L. Hellar, do hereby certify that the above and foregoing is a true and correct copy of the log of the Knoll #1 located SE NE SW Section 8-13S-18W, Ellis County, Kansas, as reflected by the files of Hellar Drilling Company, Inc.

HELLAR DRILLING COMPANY, INC.

By *D. L. Hellar*
President D. L. Hellar

Subscribed and sworn to before me, a Notary Public, in and for Sedgwick County, Kansas, this 19th day of March, 1968.

Norma J. Johnson
Notary Public - Norma J. Johnson



My commission expires: August 2, 1970