


STATE OF KANSAS  
STATE CORPORATION COMMISSION

15-051-23561-00-00  
15-051-23561-00-00  
WELL PLUGGING RECORD

Give All Information Completely  
Make Required Affidavit  
Mail or Deliver Report to  
Conservation Division  
State Corporation Comm.  
245 North Water  
Wichita, KS 67202

Ellis County, Sec. 8 Twp. 13 Rge. 18 E/W  
Location as "NE/CNW $\frac{1}{4}$ SW $\frac{1}{4}$ " or footage from lines

SW NW SW  
Lease Owner Dreiling Resources, Inc.  
Lease Name Knoll Well No. 1  
Office Address P. O. Box 278, Victoria, KS 67671  
Character of Well (Completed as Oil, Gas or Dry Hole) Dry Hole

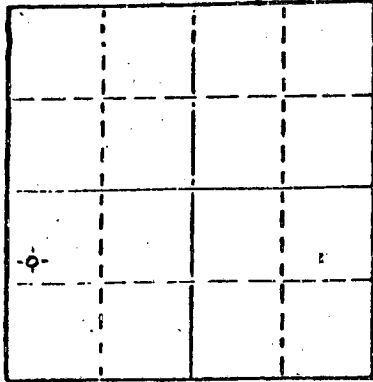

Locate well correctly on above  
Section Plat

Date Well completed 8-14 1983  
Application for plugging filed 8-14 1983  
Application for plugging approved 8-14 1983  
Plugging commenced 8-14 1983  
Plugging completed 8-14 1983  
Reason for abandonment of well or producing formation \_\_\_\_\_

If a producing well is abandoned, date of last production 19

Was permission obtained from the Conservation Division or its agents before plugging was commenced? Yes

Name of Conservation Agent who supervised plugging of this well Carl Goodrow  
Producing formation \_\_\_\_\_ Depth to top \_\_\_\_\_ Bottom \_\_\_\_\_ Total Depth of Well 3790'  
Show depth and thickness of all water, oil and gas formations.

OIL, GAS OR WATER RECORDS

CASING RECORD

FORMATION	CONTENT	FROM	TO	SIZE	PUT IN	PULLED OUT
				8 5/8"	611'	-0-

Describe in detail the manner in which the well was plugged, indicating where the mud fluid was placed and the method or methods used in introducing it into the hold. If cement or other plugs were used, state the character of same and depth placed, from \_\_\_\_\_ feet to \_\_\_\_\_ feet for each plug set.

- 1st plug was set at 3770' with 20 sacks cement
- 2nd plug was set at 1460' with 20 sacks cement
- 3rd plug was set at 615' with 40 sacks cement
- 4th plug was set at 400' with 90 sacks cement
- 5th plug was set at 40' with 10 sacks cement


(If additional description is necessary, use BACK of this sheet)

Name of Plugging Contractor Dreiling Oil, Inc., Box 1000, Victoria, KS 67671

STATE OF KANSAS COUNTY OF ELLIS, ss.  
ALFRED J. DREILING (employee of owner) or (owner or operator)  
of the above-described well, being first duly sworn on oath, says: That I have knowledge of the facts, statements, and matters herein contained and the log of the above-described well as filed and that the same are true and correct. So help me God.

(Signature) [Signature]  
P.O. Box 278 Victoria 67671  
(Address)

SUBSCRIBED AND SWORN TO before me this 24th day of August, 1983

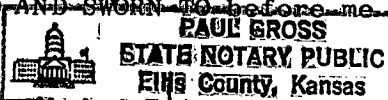

Appointment My commission expires April 7, 1984

[Signature]  
Notary Public.

RECEIVED  
STATE CORPORATION COMMISSION

AUG 25 1983  
8-25-83  
WICHITA, KANSAS