

STATE OF KANSAS
STATE CORPORATION COMMISSION
200 Colorado Derby Bldg.
Wichita, Kansas 67202

RECEIVED Form CP-4
STATE CORPORATION COMMISSION 12-15-80

AUG 30 1982
8-30-82
CONSERVATION DIVISION
Wichita, Kansas


WELL PLUGGING RECORD

Give All Information Completely
Make Required Affidavit

15-051-23092-00-00

COUNTY Ellis SEC. 16 TWP. 13S RGE. 3 XXW
Location as in quarters or footage from lines:

1550 ESL: 2310' FEL SE/4

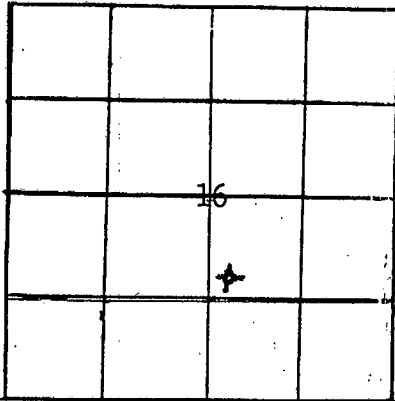

Locate Well
correctly on above
Section Platt.

Lease Owner Ernst & Steidle Oil Operations

Lease Name Frank Schmidt Well No. 3

Office Address P.O. Box 859, Russell, KS 67665

Character of Well (Completed as Oil, Gas or Dry Hole): _____

Date Well Completed July 25, 1982

Application for plugging filed July 24, 1982

Plugging commenced July 25, 1982

Plugging completed July 24, 1982

Reason for abandonment of well or producing formation D&A

Was permission obtained from the Conservation Division or it's
Agent's before plugging was commenced? yes Gilbert Scheck

Name of Conservation Agent who supervised plugging of this well Gilbert Scheck

Producing formation n/a Depth to top n/a bottom n/a T.D. 3656'

Show depth and thickness of all water, oil and gas formations.

OIL, GAS OR WATER RECORDS

Casing Record

Formation	Content	From	To	Size	Put in	Pulled Out
				8-5/8'	242.94'	-0-


Describe in detail the manner in which the well was plugged, indicating where the mud fluid was placed and the method or methods used in introducing it into the hold. If cement or other plugs were used, state the character of same and depth placed, from _____ feet to _____ feet for each plug set.

Plugged Hole
1st @ 720 w/80 sx
2nd @ 270 w/40 sx
1/2 sx hulls
Plug @ 40 w/10 sx to surface
10 sx in the rathole
BJ Hughes

(If additional description is necessary, use BACK of this sheet)

Name of Plugging Contractor B.J. Hughes
Box 111, Seminole, OK

STATE OF Kansas COUNTY OF Russell, ss.
Wayne Leo Steidle (employee of owner) or (owner or operator) of the
above-described well, being first duly sworn on oath, says: That I have knowledge of the
facts, statements, and matters herein contained and the log of the above-described well as
filed and that the same are true and correct. So help me God.

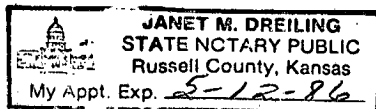

(Signature) Wayne Leo Steidle
221 Duran, KS 67634
(Address)

SUBSCRIBED AND SWORN TO before me this 25th day of August, 19 82

My Commission expires: May 12, 1986

Janet M. Dreiling
Notary Public