

STATE OF KANSAS
STATE CORPORATION COMMISSION

Form CP-4


Give All Information Completely
Make Required Affidavit
Mail or Deliver Report to:
Conservation Division
State Corporation Commission

P. O. Box 17027
Wichita, Kansas 67217
NORTH

15:051:20932:00:00
WELL PLUGGING RECORD

Ellis County, Sec. 16 Twp. 13S Rge. 17 (E) (W) XX

Location as "NE/CNW&SW&" or footage from lines N/2 SW SW
Lease Owner Big J. Production Co., Inc.
Lease Name Schmidt Well No. 1
Office Address 357 Lulu, Wichita, Kansas 67211
Character of Well (completed as Oil, Gas or Dry Hole) D & A
Date well completed January 6 1974
Application for plugging filed January 6 1974
Application for plugging approved January 6 1974
Plugging commenced January 6 1974
Plugging completed January 6 1974
Reason for abandonment of well or producing formation D & A

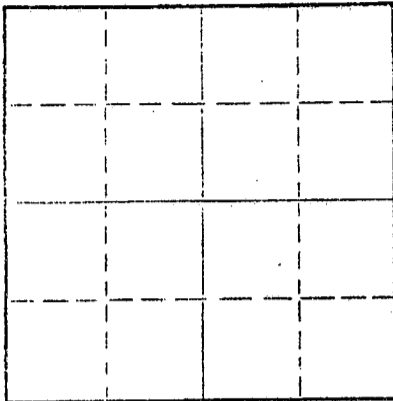

Locate well correctly on above Section Plat

If a producing well is abandoned, date of last production _____ 19____
Was permission obtained from the Conservation Division or its agents before plugging was commenced? Yes

Name of Conservation Agent who supervised plugging of this well Mr. Leo F. Massey
Producing formation _____ Depth to top _____ Bottom _____ Total Depth of Well 3630' Feet

Show depth and thickness of all water, oil and gas formations.

OIL, GAS OR WATER RECORDS

CASING RECORD

FORMATION	CONTENT	FROM	TO	SIZE	PUT IN	PULLED OUT
				8-5/8"	199'	-0-

Describe in detail the manner in which the well was plugged, indicating where the mud fluid was placed and the method or methods used in introducing it into the hole. If cement or other plugs were used, state the character of same and depth placed, from _____ feet to _____ feet for each plug set.

50 sx. cement @ 500'
25 sx. cement @ 185'
10 sx. cement @ 40'

RECEIVED
STATE CORPORATION COMMISSION
JAN 14 1974
1-14-74
CONSERVATION DIVISION
Wichita, Kansas

(If additional description is necessary, use BACK of this sheet)


Name of Plugging Contractor Red Tiger Drilling Company
Address 1720 Wichita Plaza, Wichita, Kansas 67202

STATE OF Kansas COUNTY OF Sedgwick, ss.
D'Ann Drennan (employee of owner) or (owner or operator) of the above-described well, being first duly sworn on oath, says: That I have knowledge of the facts, statements, and matters herein contained and the log of the above-described well as filed and that the same are true and correct. So help me God.

(Signature) D'Ann Drennan
1720 Wichita Plaza, Wichita, Kansas 67202
(Address)

Subscribed and sworn to before me this 8th day of January, 19 74

My commission expires 12/31, 1977
Linda C. Nowrey Notary Public.

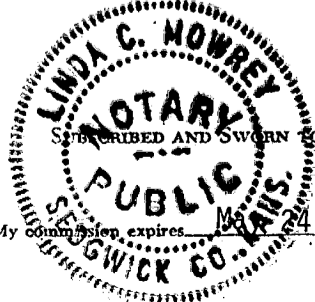

DRILLERS LOG

No. 1 Schmidt

<u>CASING RECORD:</u>	COMPANY: Big J. Production Co., Inc.	DESCRIPTION:
8-5/8" @ 199'	CONTRACTOR: Red Tiger Drilling Co.	N/2 SW SW
w/125 sx. cement	COMMENCED: December 26, 1973	16-13S-17W
		Ellis County
		Kansas
TOTAL DEPTH: 3630'	COMPLETED: January 6, 1974	

ELEVATION:

15-051-20932-00-00

<u>FORMATION</u>	<u>FROM</u>	<u>TO</u>	<u>REMARKS</u>
Clay, Post Rock & Shale	0	202	
Shale	202	675	
Sand	675	892	
Shale	892	1050	
Redbed	1050	1251	
Anhydrite	1251	1288	
Shale	1288	1695	
Shale & Lime	1695	3035	
Lime	3035	3630	

RECEIVED
STATE CORPORATION COMMISSION
JAN 14 1974
CONSERVATION DIVISION
Wichita, Kansas

I certify that this is a true and correct copy of the above log to the best of my knowledge.

RED TIGER DRILLING COMPANY

D'Ann Drennan
D'Ann Drennan

Subscribed and sworn to before me this 8th day of January, 1974.

Linda C. Mowrey
Notary Public

My Commission Expires:

May 24, 1977

