

STATE OF KANSAS
STATE CORPORATION COMMISSION

15051-22334-00-00
WELL PLUGGING RECORD

Give All Information Completely
Make Required Affidavit
Mail or Deliver Report to
Conservation Division
State Corporation Comm.
245 North Water
Wichita, KS 67202

Ellis County, Sec. 16 Twp. 13 S. Rge. 17 E/W
Location as "NE/CNW $\frac{1}{4}$ /SW $\frac{1}{4}$ " or footage from lines
W $\frac{1}{2}$ SE SW

Lease Owner Thomas Wiesner
Lease Name Schmidt Well No. 2

Office Address 2725 Colnoia, Apt A Hays, Kansas 67601
Character of Well (Completed as Oil, Gas or Dry Hole)

Dry hole


Date Well completed May 5 19 81
Application for plugging filed May 5 19 81
Application for plugging approved May 5 19 81
Plugging commenced May 5 19 81
Plugging completed May 5 19 81

Reason for abandonment of well or producing formation
Dry hole

If a producing well is abandoned, date of last production
19

Was permission obtained from the Conservation Division or
its agents before plugging was commenced? Yes

Name of Conservation Agent who supervised plugging of this well Marion Schmidt
Producing formation Depth to top Bottom Total Depth of Well 3600'
Show depth and thickness of all water, oil and gas formations.

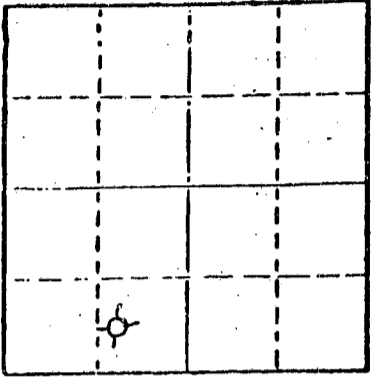

Locate well correctly on above
Section Plot

OIL, GAS OR WATER RECORDS

CASING RECORD

FORMATION	CONTENT	FROM	TO	SIZE	PUT IN	PULLED OUT
Surface		0	222'	8 5/8"	222'	0

Describe in detail the manner in which the well was plugged, indicating where the mud fluid was placed and the method or methods used in introducing it into the hold. If cement or other plugs were used, state the character of same and depth placed, from feet to feet for each plug set.

1st Plug set at 660' with 65 sacks common cement 50-50 Poz 6% gel

2nd Plug set at 240' with 30 sacks common cement 50-50 Poz 6% gel

3rd Plug set at 40' with 10 sacks common cement 50-50 Poz 6% gel

5 Sacks in rathole

Heavy drilling mud between each plug

(If additional description is necessary, use BACK of this sheet)

Name of Plugging Contractor Halliburton

RECEIVED
STATE CORPORATION COMMISSION
JUN 1 1981

CONSERVATION DIVISION
Wichita, Kansas

STATE OF Kansas COUNTY OF Graham ss. Jerry M. Helberg (employee of owner) or (owner or operator)

of the above-described well, being first duly sworn on oath, says: That I have knowledge of the facts, statements, and matters herein contained and the log of the above-described well as filed and that the same are true and correct. So help me God.

(Signature)

Box 32, Morland, Kansas 67650
(Address)

SUBSCRIBED AND SWORN TO before me this 29 day of May, 19 81

Faye E. Minium
Notary Public.

My commission expires



DRILLERS LOG

SCHMIDT #2

CASING RECORD:

8 5/8" set at 222'

TOTAL DEPTH:

3600'

DESCRIPTION:

W 1/2 SE SW

Sec. 16 Twp. 13S Rge. 17W Ellis County, Kansas

OPERATOR: Thomas Wiesner

CONTRACTOR: Helberg Oil Company

COMMENCED: April 27, 1981

COMPLETED: May 5, 1981

15:051-22334-00-00

FORMATION	FROM	TO	REMARKS
Sand & Shale	0	74	
Sand & Shale	74	237	
Sand & Shale	237	640	
Anhydrite	640	1244	
Sand & Shale	1244	1270	
Sand & Shale	1270	1618	
Shale	1618	1960	
Lime & Shale	1960	2148	
Shale	2148	2238	
Shale	2238	2358	
Lime & Shale	2358	2495	
Lime & Shale	2495	2632	
Lime & Shale	2632	2768	
Lime & Shale	2768	2905	
Shale	2905	3040	
Shale	3040	3138	
Lime & Shale	3138	3214	
Lime & Shale	3214	3302	
Shale	3302	3352	
Shale	3352	3427	
Shale	3427	3515	
Shale	3515	3572	
Shale	3572	3600	
T.D.	3600		

RECEIVED
STATE CORPORATION COMMISSION
JUN - 1 1981
CONSERVATION DIVISION
Wichita, Kansas

D & A

I certify that the above is a true and correct copy of the log to the best of my knowledge.

Helberg Oil Company

Jerry M. Helberg
Jerry M. Helberg

Subscribed and sworn to before me this 29 day of May, 1981.

Amy E. Minniew
Notary Public

My commission expires _____

