

STATE OF KANSAS
STATE CORPORATION COMMISSION

15:057-21887-00-00
WELL PLUGGING RECORD

Give All Information Completely
Make Required Affidavit
Mail or Deliver Report to
Conservation Division
State Corporation Comm.
245 North Water
Wichita, KS 67202

Ellis County, Sec. 16 Twp. 13 Rge. 17 E/W
Location as "NE/CNW $\frac{1}{4}$ SW $\frac{1}{4}$ " or footage from lines
NW Tract #36


Lease Owner B & F Oil Company
Lease Name Meise Well No. 1
Office Address 100 D. Cody Hays, Kansas 67601
Character of Well (Completed as Oil, Gas or Dry Hole) Dry hole

Date Well completed 2-27 1980
Application for plugging filed 2-27 1980
Application for plugging approved 2-27 1980
Plugging commenced 2-27 1980
Plugging completed 2-27 1980

Reason for abandonment of well or producing formation dry hole
If a producing well is abandoned, date of last production 19

Was permission obtained from the Conservation Division or its agents before plugging was commenced? yes

Name of Conservation Agent who supervised plugging of this well Marion Schmidt
Producing formation _____ Depth to top _____ Bottom _____ Total Depth of Well 13587
Show depth and thickness of all water, oil and gas formations.

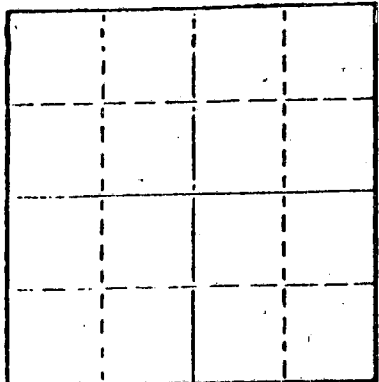

Locate well correctly on above Section Plot

OIL, GAS OR WATER RECORDS

CASING RECORD

FORMATION	CONTENT	FROM	TO	SIZE	PUT IN	PULLED OUT
Surface		0	220'	8 5/8"	220	0

Describe in detail the manner in which the well was plugged, indicating where the mud fluid was placed and the method or methods used in introducing it into the hold. If cement or other plugs were used, state the character of same and depth placed, from _____ feet to _____ feet for each plug set.

- 1st Plug at 660' with 70 sacks cement 50-50 poz 6% gel.
- 2nd Plug at 200' with 20 sacks cement 50-50 poz 6% gel.
- 3 rd Plug at 10' with 40 sacks cement 50-50 poz 6% gel. solid bridge
- 5 sacks in rathole

RECEIVED
STATE CORPORATION COMMISSION
3-6-80
MAR - 6 - 80
CONSERVATION DIVISION
Wichita, Kansas

(If additional description is necessary, use BACK of this sheet)
Name of Plugging Contractor Sun Oil Well Cementing, Inc.

STATE OF Kansas COUNTY OF Graham, ss.
Jerry M. Helberg (employee of owner) or (owner or operator)
of the above-described well, being first duly sworn on oath, says: That I have knowledge of the facts, statements, and matters herein contained and the log of the above-described well as filed and that the same are true and correct. So help me God.

(Signature)

Jerry M. Helberg
Box 32 Morland, Kansas 67650
(Address)

SUBSCRIBED AND SWORN TO before me this 27th day of Feb., 1980

Janice Robinson
Notary Public.

My commission expires

Dec. 4, 1983



DRILLERS LOG

MEIES #1

CASING RECORD:

8 5/8" set at 220'

TOTAL DEPTH:

3587'

DESCRIPTION:

Nw Tract #36
Sec. 16-13-17, Ellis County, Kansas

OPERATOR: B & F Oil Company

CONTRACTOR: Helberg Oil Company

COMMENCED: February 19, 1980

COMPLETED: February 27, 1980

FORMATION	FROM	TO	REMARKS
Sand & Shale	0	230	
Sand & Shale	230	280	
Sand & Shale	280	1170	
Sand & Shale	1170	1258	
Anhydrite	1258	1295	
Shale & Lime	1295	1419	
Lime & Shale	1419	1600	
Shale & Lime	1600	1969	
Shale & Lime	1969	2146	
Lime & Shale	2146	2266	
Lime & Shale	2266	2350	
Shale & Lime	2350	2520	
Lime & Shale	2520	2610	
Lime & Shale	2610	2708	
Shale & Lime	2708	2853	
Lime & Shale	2853	2914	
Lime & Shale	2914	3030	
Lime & Shale	3030	3160	
Lime & Shale	3160	3240	
Lime	3240	3319	
Shale & Lime	3319	3400	
Shale & Lime	3400	3469	
Shale & Lime	3469	3530	
Shale & Lime	3530	3552	
Lime	3552	3587	
T.D.	3587		

15051-21887-00-00

RECEIVED
STATE COMMISSION
MAR - 6 1980
GENERAL INVESTIGATION DIVISION
Topeka, Kansas
D & A

This is a true and correct copy of the above log to the best of my knowledge.

HELBERG OIL COMPANY

Jerry M. Helberg
Jerry M. Helberg

Subscribed and sworn to before me this 5th day of March, 1980.

Janice Schmitt
Notary Public

My commission expires Nov. 4, 1983.

