


STATE OF KANSAS
STATE CORPORATION COMMISSION

Give All Information Completely
Make Required Affidavit
Mail or Deliver Report to:
Conservation Division
State Corporation Commission
211 No. Broadway
Wichita, Kansas

15051005900000
WELL PLUGGING RECORD

NORTH

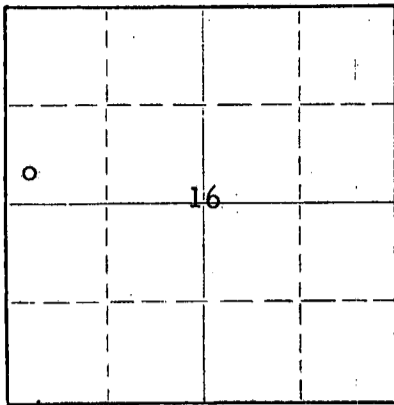

Locate well correctly on above
Section Plat

Ellis County, Sec. 16 Twp. 13 Rge. 17W (E) (W)

Location as "NE/CNW%SW%" or footage from lines SW SW NW
Lease Owner Burch Drilling Co., Inc.
Lease Name Catherine Community Well No. 1
Office Address 1011 Union Center - Wichita, Kansas
Character of Well (completed as Oil, Gas or Dry Hole) dry hole
Date well completed 10-25-19 57
Application for plugging filed 10-25-19 57
Application for plugging approved 10-25-19 57
Plugging commenced 10-25-19 57
Plugging completed 10-25-19 57
Reason for abandonment of well or producing formation dry

If a producing well is abandoned, date of last production 19
Was permission obtained from the Conservation Division or its agents before plugging was commenced? yes

Name of Conservation Agent who supervised plugging of this well Eldon Petty
Producing formation _____ Depth to top _____ Bottom _____ Total Depth of Well 360 Feet
Show depth and thickness of all water, oil and gas formations.

OIL, GAS OR WATER RECORDS

CASING RECORD

FORMATION	CONTENT	FROM	TO	SIZE	PUT IN	PULLED OUT
				8 5/8	8 5/8 190'	none

Describe in detail the manner in which the well was plugged, indicating where the mud fluid was placed and the method or methods used in introducing it into the hole. If cement or other plugs were used, state the character of same and depth placed, from _____ feet to _____ feet for each plug set.

Set 1st plug at 600' w/20 sx. cement.
Set 2nd plug at 180' w/15 sx. cement.
Set 3rd plug at 40' w/10 sx. cement.

(If additional description is necessary, use BACK of this sheet)

Name of Plugging Contractor Burch Drilling Co., Inc.
Address 1011 Union Center - Wichita, Kansas

STATE OF Kansas, COUNTY OF Sedgwick, ss.
Earl M. Burch (employee or owner) or (owner or operator) of the above-described well, being first duly sworn on oath, says: That I have knowledge of the facts, statements, and matters herein contained and the log of the above-described well as filed and that the same are true and correct. So help me God.

(Signature) Earl M. Burch

(Address)

SUBSCRIBED AND SWORN TO before me this 29th day of October, 1957.

Betty Spriggs

Notary Public.

My commission expires 6-13-59

RECEIVED
STATE CORPORATION COMMISSION

OCT 30 1957
10:30
CONSERVATION DIVISION
Wichita, Kansas

PLUGGING
FILE SEC 16 T. 13 R. 17W
BOOK PAGE 58 LINE 2

DRILLERS LOG

Burch Drilling Co., Inc.
Comm: 10-15-57
Comp: 10-25-57
8 5/8" @ 190' w/125 SK.
D & A

#1 Catherine Community
SW SW NW 16-13S-17W
Ellis County, Kansas
Elevation: 2001 KB

15057-00590-0000

Tops:

40	Soil & Rock
390	Shale & Shells
900	Shale, Sand
1250	Red Bed, Shells
1295	Anhydrite
2465	Lime & Shale
2610	Lime & Shale streaks
3350	Lime & Shale
3601	Lime
3601	RTD

Heebner	3265
Toronto	3284
Lansing	3307
BK C	3530
Simpson shale	3579
No Arbuckle	

State of Kansas, County of Sedgwick: ss

Earl M. Burch, president of Burch Drilling Co., Inc., operator of the above-described well, being first duly sworn on oath, says: That I have knowledge of the facts, statements, and matters herein contained and the log of the above-described well as filed and that the same are true and correct.

Earl M. Burch
Earl M. Burch

Subscribed and sworn to before me this 29th day of October, 1957.

My commission expires: 6-13-59

RECEIVED
CORPORATION COMMISSION

OCT 30 1957

CONSERVATION DIVISION
Wichita, Kansas

Betty Springs
Notary Public

PLUGGING
FILE SEC 16 T 13 R 17W
BOOK PAGE 58 LINE 2