


STATE OF KANSAS  
STATE CORPORATION COMMISSION

15-051-00400-0000  
WELL PLUGGING RECORD

Give All Information Completely  
Make Required Affidavit  
Mail or Deliver Report to:  
Conservation Division  
State Corporation Commission  
800 Biting Building  
Wichita, Kansas

Ellis County, Sec. 23 Twp. 13 Rge. 18 (E) (W)

NORTH

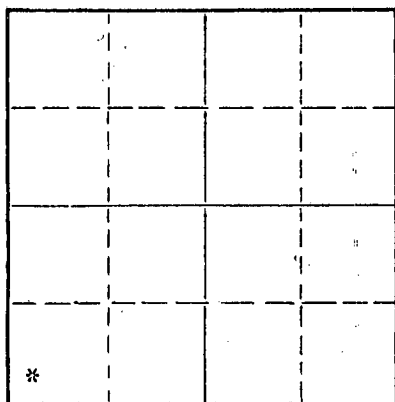

Locate well correctly on above  
Section Plat

Location as "NE/CNWxSWx" or footage from lines SW SW SW  
Lease Owner Altman Petroleum Company  
Lease Name Witt Well No. 1  
Office Address 118 N. Boulder Tulsa, Oklahoma  
Character of Well (completed as Oil, Gas or Dry Hole) dry hole  
Date well completed April 17 19 56  
Application for plugging filed April 17 19 56  
Application for plugging approved April 17 19 56  
Plugging commenced April 17 19 56  
Plugging completed 10:00 p.m. April 17 19 56  
Reason for abandonment of well or producing formation dry hole

If a producing well is abandoned, date of last production 19  
Was permission obtained from the Conservation Division or its agents before plugging was commenced? Yes

Name of Conservation Agent who supervised plugging of this well Eldon Petty  
Producing formation Depth to top Bottom Total Depth of Well 3745 Feet  
Show depth and thickness of all water, oil and gas formations.

OIL, GAS OR WATER RECORDS

CASING RECORD

FORMATION	CONTENT	FROM	TO	SIZE	PUT IN	PULLED OUT
Surface Pipe		-0-	222	8 5/8	222	-0-

Describe in detail the manner in which the well was plugged, indicating where the mud fluid was placed and the method or methods used in introducing it into the hole. If cement or other plugs were used, state the character of same and depth placed, from feet to feet for each plug set.

Pumped heavy mud down hole.  
Filled hole to 210' with heavy rotary mud.  
Dumped 1/3 sack hulls. Plug on top.  
Dumped 20 sacks cement on top of plug.  
Filled hole to 35' with heavy mud.  
Ran 1/3 sack hulls under plug.  
Set plug. Dumped 1/3 sack hulls.  
Set plug at 35'. Dumped 10 sacks cement.

(If additional description is necessary, use BACK of this sheet)

Name of Plugging Contractor A. L. Jackson Drilling Company  
Address Box 194 Great Bend, Kansas


STATE OF Kansas, COUNTY OF Barton, ss.  
A. L. Jackson, drilling contractor on (employee of owner) or (owner or operator) of the above-described well, being first duly sworn on oath, says: That I have knowledge of the facts, statements, and matters herein contained and the log of the above-described well as filed and that the same are true and correct. So help me God.

(Signature) A. L. Jackson  
Box 194 Great Bend, Kansas  
(Address)

SUBSCRIBED AND SWORN to before me this 18th day of April, 19 56

Notary Public

My commission expires May 9, 1959

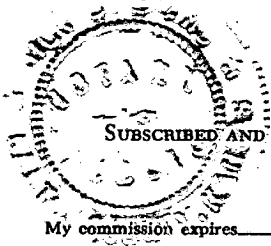

RECEIVED  
CORPORATION COMMISSION

APR 25 1956  
4-25-56  
CONSERVATION DIVISION  
Wichita, Kansas

PLUGGING  
FILE SEC. 23 T. 13 R. 18W  
BOOK PAGE 55 LINE 5

Well Log  
Witt # 1  
SW SW SW 23-12-18  
Ellis County, Kansas

15-051-00400-00-00

0 - 155	Surface clay and post rock
155 - 222	Blue shale and shells
222 - 480	Shale
480 - 745	Red bed and shale
745 - 990	Sand
990 - 1060	Shale and red bed
1060 - 1308	Red bed, shale and shells
1308 - 1360	Anhydrite
1360 - 1485	Shale and shells
1485 - 1795	Shale and lime - shells
1795 - 1850	Salt and shale
1850 - 1940	Shale and shells
1940 - 2100	Lime and shale
2100 - 2245	Shale and shells
2245 - 2255	Shale and lime
2255 - 2320	Lime
2320 - 2410	Lime - broken
2410 - 3074	Shale and lime
3074 - 3120	Lime (Topeka
3120 - 3314	Lime
3314 - 3354	Shale and lime
3354 - 3400	Lime and shale
3400 - 3418	Lime
3418 - 3550	K. C. Lime
3550 - 3585	Lime
3585 - 3635	Lime and Conglomerate
3635 - 3695	Conglomerate (Cherty)
3695 - 3715	Lime and chert - Conglomerate
3715 - 3745	Arbuckle lime
3745	Lime

STATE OF KANSAS

COUNTY OF BARTON ss


A. L. Jackson, owner of A. L. Jackson Drilling Company, being first duly sworn on oath says: That I have knowledge of the facts, statements, and matters herein contained and the log of the above described well as filed and that the same are true and correct.

A. L. Jackson  
A. L. Jackson

Subscribed and sworn before me this 18th day of April, 1956.

Dick B. Evans  
Dick B. Evans  
Notary Public - Barton County

My Commission expires May 9, 1959

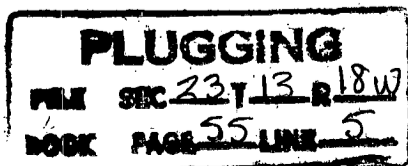

RECEIVED  
STATE CORPORATION COMMISSION

APR 25 1956

CONSERVATION DIVISION  
Wichita, Kansas