

CARD MUST BE TYPED

State of Kansas NOTICE OF INTENTION TO DRILL

(see rules on reverse side)

CARD MUST BE SIGNED

Starting Date: 6 / 23 / 85
month day year

OPERATOR: License # 8362 (HBP) / 4000 (SETCO)
Name Held By Production, Inc./SETCO
Address 1625 Broadway, Suite 410
City/State/Zip Denver, Colorado 80202
Contact Person Marc T. Eckels
Phone 303/534-4445

CONTRACTOR: License # 5829
Name Aldebaran Drilling Co., Inc.
City/State Pratt, Kansas

Well Drilled For: Well Class: Type Equipment:

☒ Oil ☐ Swd ☐ Infield ☒ Mud Rotary
☐ Gas ☐ Inj ☐ Pool Ext. ☐ Air Rotary
☐ OWWO ☐ Expl ☒ Wildcat ☐ Cable

If OWWO: old well info as follows:

Operator
Well Name
Comp Date Old Total Depth
Projected Total Depth 4,020 feet
Projected Formation at TD Arbuckle
Expected Producing Formations Lansing, Marmaton, Cherokee, Mississippian, & Arbuckle.

I certify that we will comply with K.S.A. 55-101, et seq., plus eventually plugging hole to K.C.C. specifications.

Date 3/27/85 Signature of Operator or Agent

Marc T. Eckels

API Number 15- 195-21, 703-00-00

se ne se Sec 23 Twp 13 S, Rge 21
(location)

☐ East

☒ West

1,450 Ft North from Southeast Corner of Section
330 Ft West from Southeast Corner of Section
(Note: Locate well on Section Plat on reverse side)

Nearest lease or unit boundary line 330 feet.

County Trego

Lease Name Kroeger Well# 23-9-D

Domestic well within 330 feet: ☐ yes ☒ no

Municipal well within one mile: ☐ yes ☒ no

Depth to Bottom of fresh water 200 feet

Lowest usable water formation Dakota

Depth to Bottom of usable water est. 1,100 850 feet

Surface pipe by Alternate: 1 ☐ 2 ☒

Surface pipe to be set 250 feet

Conductor pipe if any required NA feet

Ground surface elevation 2,237 feet MSL

This Authorization Expires 10-1-85

Approved By 4-1-85

SEC./Treasurer (SETCO)

Form C-1 4/84

MHC/40HE 4-1-85


Must be filed with the K.C.C. five (5) days prior to commencing well
This card void if drilling not started within six (6) months of date received by K.C.C.

RECEIVED
STATE CORPORATION COMMISSION

04-01-85
APR - 1 1985

A Regular Section of Land

1 Mile = 5,280 Ft. CONSERVATION DIVISION
Wichita, Kansas

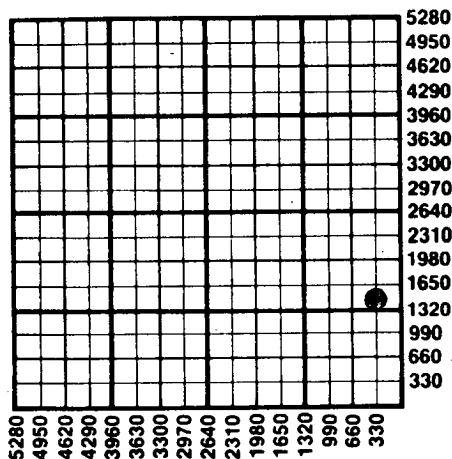

Important procedures to follow :

1. Notify District office before setting surface casing.
2. Set surface casing by circulating cement to the top.
3. File completion forms ACO-1 with K.C.C. within 90 days of well completion, following instructions on ACO-1, side 1, and including copies of wireline logs.
4. Notify District office 48 hours prior to old well workover or re-entry.
5. Prior to plugging, prepare a plugging plan, then obtain agreement from the appropriate district office for an approved plugging plan.
6. Submit plugging report (CP-4) to K.C.C. after plugging is completed.
7. Obtain an approved injection docket number before disposing of salt water.
8. Notify K.C.C. within 10 days when injection commences or terminates.
9. If an alternate 2 completion, cement in the production pipe from below any usable water to surface within 120 days of spud date.

State Corporation Commission of Kansas
Conservation Division
200 Colorado Derby Building
Wichita, Kansas 67202
(316) 263-3238