

CARD MUST BE TYPED

State of Kansas
NOTICE OF INTENTION TO DRILL
 (see rules on reverse side)

CARD MUST BE SIGNED

Starting Date: August 7, 1985
 month day year

OPERATOR: License # 5601
 Name Associated Petroleum Consultants, Inc.
 Address Suite 600 - One Main Place
 City/State/Zip Wichita, Kansas 67202
 Contact Person Mike Sevier
 Phone (316) 265-9385

CONTRACTOR: License # 5422
 Name Abercrombie Drilling, Inc.
 City/State Wichita, Kansas

Well Drilled For:		Well Class:	Type Equipment:
☒ Oil	☐ Swd	☐ Infield	☒ Mud Rotary
☐ Gas	☐ Inj	☐ Pool Ext.	☐ Air Rotary
☐ OWWO	☐ Expl	☒ Wildcat	☐ Cable

If OWWO: old well info as follows:

Operator
 Well Name
 Comp Date Old Total Depth
 Projected Total Depth 4200' feet
 Projected Formation at TD Mississippi
 Expected Producing Formations Lansing-Kansas City

I certify that we will comply with K.S.A. 55-101, et seq., plus eventually plugging hole to K.C.C. specifications.

Date 8/2/85 Signature of Operator or Agent

Charles R. King

API Number 15- 195-2,762-00-00

SE NW SW Sec 4 Twp 13 S, Rge 22 ☐ East
 (location) ☒ West

1650 Ft North from Southeast Corner of Section
 4290 Ft West from Southeast Corner of Section
 (Note: Locate well on Section Plat on reverse side)

Nearest lease or unit boundary line 990 feet.
 County Irego
 Lease Name Mai Well# 1

Domestic well within 330 feet: ☐ yes ☒ no
 Municipal well within one mile: ☐ yes ☒ no

Depth to Bottom of fresh water 150 feet
 Lowest usable water formation ~~100~~ ^{Dakota}
 Depth to Bottom of usable water 950 feet
 Surface pipe by Alternate: ~~2 1/2~~
 Surface pipe to be set 240 feet
 Conductor pipe if any required None feet
 Ground surface elevation 2300 feet MSL
 This Authorization Expires 2-5-89
 Approved By 8-5-85

RCH for KOAF


President

Must be filed with the K.C.C. five (5) days prior to commencing well
This card void if drilling not started within six (6) months of date received by K.C.C.

RECEIVED
STATE CORPORATION COMMISSION

Important procedures to follow:

A Regular Section of Land
1 Mile = 5,280 Ft.

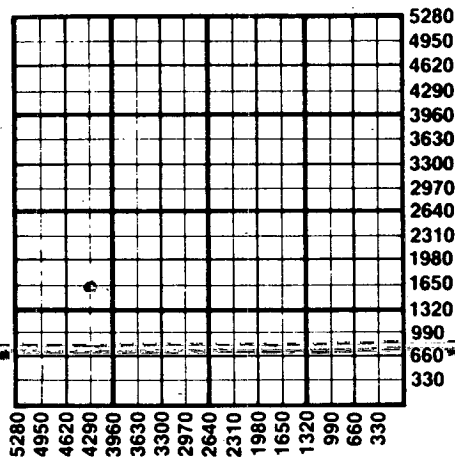

1. Notify District office before setting surface casing.
2. Set surface casing by circulating cement to the top.
3. File completion forms ACO-1 with K.C.C. within 90 days of well completion, following instructions on ACO-1, side 1, and including copies of wireline logs.
4. Notify District office 48 hours prior to old well workover or re-entry.
5. Prior to plugging, prepare a plugging plan, then obtain agreement from the appropriate district office for an approved plugging plan.
6. Submit plugging report (CP-4) to K.C.C. after plugging is completed.
7. Obtain an approved injection docket number before disposing of salt water.
8. Notify K.C.C. within 10 days when injection commences or terminates.
9. If an alternate 2 completion, cement in the production pipe from below any usable water to surface within 120 days of spud date.

AUG 5 1985
08-05-85

CONSERVATION DIVISION
Wichita, Kansas

State Corporation Commission of Kansas
Conservation Division
200 Colorado Derby Building
Wichita, Kansas 67202
(316) 263-3238