

NOTICE OF INTENTION TO DRILL

(see rules on reverse side)

Starting Date 6-10-86 month day year

API Number 15- 195-21,861-00-00

OPERATOR: License # 6133
Name TRIPLE "H" OIL OPERATIONS
Address P.O. BOX 248
City/State/Zip HAYS, KS 67601
Contact Person CARL ZIMMERMAN
Phone (913) 628-6442

NE SE SW/4 Sec. 34 Twp. 13 S, Rg. 21
990 Ft. from South Line of Section
2970 Ft. from East Line of Section

(Note: Locate well on Section Plat on reverse side)

CONTRACTOR: License # 4087
Name WILLIAMSON DRILLING, INC.
City/State GREAT BEND, KS

Nearest lease or unit boundary line 330 feet
County TREGO

Well Drilled For: Well Class: Type Equipment:
[X] Oil [] SWD [] Infield [X] Mud Rotary
[] Gas [] Inj [X] Pool Ext. [] Air Rotary
[] OWWO [] Expl [] Wildcat [] Cable

Lease Name HONAS Well # 1
Ground surface elevation N/A feet MSL
Domestic well within 330 feet: [] yes [X] no
Municipal well within one mile: [] yes [X] no
Surface pipe by Alternate: 1 [] 2 [X]
Depth to bottom of fresh water 50
Depth to bottom of usable water 1000
Surface pipe planned to be set 250
Projected Total Depth 4000 feet
Formation ARBUCKLE

If OWWO: old well info as follows:

Operator
Well Name
Comp Date Old Total Depth

I certify that well will comply with K.S.A. 55-101, et seq., plus eventually plugging hole to KCC specifications.

Date 6-7-86 Signature of Operator or Agent Dale J. Fawcett Title PARTNER

For KCC Use:

Conductor Pipe Required feet; Minimum Surface Pipe Required 250 feet per Alt.
This Authorization Expires 12-10-86 Approved By 6-10-86

Handwritten signature: Peth/KDHE


Handwritten initials: Peth

Must be filed with the K.C.C. five (5) days prior to commencing well
This card void if drilling not started within six (6) months of date received by K.C.C.

Important procedures to follow:

1. Notify District office before setting surface casing.
2. Set surface casing by circulating cement to the top.
3. File completion forms ACO-1 with K.C.C. within 90 days of well completion, following instructions on ACO-1, side 1, and including copies of wireline logs.
4. Notify District office 48 hours prior to old well workover or re-entry.
5. Prior to filing Intent, prepare a proposed plugging plan in case well is D & A, then obtain approval of plan when calling district office prior to setting surface pipe.
6. Submit plugging report (CP-4) to K.C.C. after plugging is completed.
7. Obtain an approved injection docket number before disposing of salt water.
8. Notify K.C.C. within 10 days when injection commences or terminates.
9. If an alternate 2 completion, cement in the production pipe from below any usable water to surface within 120 days of spud date.

A Regular Section of Land
1 Mile = 5,280 Ft.

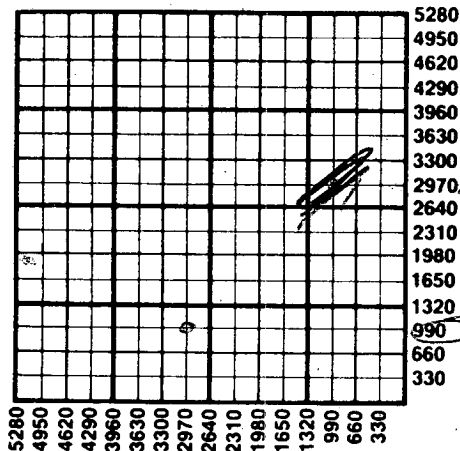

RECEIVED
STATE CORPORATION COMMISSION

JUN 10 1986

CONSERVATION DIVISION
Wichita, Kansas

06-10-86

State Corporation Commission of Kansas
Conservation Division
200 Colorado Derby Building
Wichita, Kansas 67202
(316) 263-3238