


Give All Information Completely
Make Required Affidavit
Mail or Deliver Report to:
Conservation Division
State Corporation Commission
212 North Market, Insurance Bldg.
Wichita, Kansas

WELL PLUGGING RECORD

NORTH

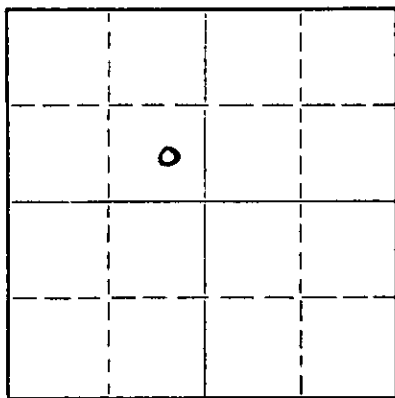

Locate well correctly on above
Section Plat

Ness County. Sec. 4 Twp. 20S Rge. 24 (E) W (W)
Location as "NE/CNW&SW&" or footage from lines 150' E of C NE NW
Lease Owner Colorado Oil & Gas Corporation
Lease Name Lundy-Hair Well No. 3
Office Address Denver Club Bldg., Denver, Colorado
Character of Well (completed as Oil, Gas or Dry Hole) Dry Hole
Date well completed Jan. 25 19 61
Application for plugging filed Jan. 25 19 61
Application for plugging approved Jan. 25 19 61
Plugging commenced Jan. 25 19 61
Plugging completed Jan. 25 19 61
Reason for abandonment of well or producing formation Dry Hole

If a producing well is abandoned, date of last production _____ 19____
Was permission obtained from the Conservation Division or its agents before plugging was commenced? Yes

Name of Conservation Agent who supervised plugging of this well Gilbert P. Leiker
Producing formation _____ Depth to top _____ Bottom _____ Total Depth of Well 4440 Feet
Show depth and thickness of all water, oil and gas formations.

OIL, GAS OR WATER RECORDS

CASING RECORD

FORMATION	CONTENT	FROM	TO	SIZE	PUT IN	PULLED OUT
		0	283	8 5/8"	283	None

Describe in detail the manner in which the well was plugged, indicating where the mud fluid was placed and the method or methods used in introducing it into the hole. If cement or other plugs were used, state the character of same and depth placed, from _____ feet to _____ feet for each plug set.

4440' to 600' - Heavy rotary mud
600' to 538' - 1/2 sack hulls, plug and 20 sacks cement
538' to 240' - heavy rotary mud
240' to 178' - 1/2 sack hulls, plug and 20 sacks cement
178' to 40' - heavy rotary mud
40' to 6' - 1/2 sack hulls, plug and 10 sacks cement
6' to 0' - cellar

1-30-61
S.M.

(If additional description is necessary, use BACK of this sheet)

Name of Plugging Contractor Peel Brothers, Inc.
Address P. O. Box 359, Hoisington, Kansas

STATE OF KANSAS, COUNTY OF BARTON, ss.
Peel Brothers, Inc. (employee of owner) or (owner/contractor) of the above-described well, being first duly sworn on oath, says: That I have knowledge of the facts, statements, and matters herein contained and the log of the above-described well as filed and that the same are true and correct. So help me God. Peel Brothers, Inc.

(Signature) BY James Mattick
P. O. Box 359, Hoisington, Kansas
(Address)

SUBSCRIBED AND SWORN TO before me this 25 day of January, 19 61
Luth Brank
Notary Public.

My commission expires April 27, 1964

15-135-19060000

DRILLERS' LOG

Well Owner: Colorado Oil & Gas Corp.
Well Name: Lundy-Hair Well No. 3
Total Depth: 4440'
Commenced: 1/8/61
Completed: 1/25/61
Casing: 8 5/8" @ 283' con.

150' East of C NE NW
Sec. 4, Twp. 20S, Rge. 24W
Ness County,
Kansas
Elevation:

Contractor: Peel Brothers, Inc. Production: Dry

Figures below indicate bottoms of formations:

Surface clay	0 -	100
Shale & shells		284
Shale & sand		600
Shale & shells		620
Shale, shells & red bed		1370
Red bed		1590
Anhydrite		1623
Shale & shells		2250
Shale & lime		2685
Lime		2757
Lime & shale		2950
Lime		3125
Shale & lime		3250
Lime		3420
Chalky lime		3559
Chalk, lime & shells		3603
Chalky lime		3773
Lime		4440
Total Depth		4440

This is to certify that the above information is to the best of our knowledge, true and correct.

PEEL BROTHERS, INC.

BY: Joseph Matthews

SUBSCRIBED AND SWORN to before me this 25 day of January, 1961

My commission expires: April 27, 1964.

Luth Braut
Notary Public

NOTARY PUBLIC
STATE OF KANSAS
JAN 25 1961
COMMISSION EXPIRES
Wichita