

15-053-20446-000

STATE OF KANSAS
STATE CORPORATION COMMISSION
CONSERVATION DIVISION
P. O. BOX 17027
WICHITA, KANSAS 67217

FORM CP-4

WELL PLUGGING RECORD

Ellsworth County, Sec. 20 Twp. 17s Rgn. (E) 10(W)

Location as "NE/CN/WSW" or footage from face SW SE NW

Lease Owner Jayhawk Oil Co

Lease Name Schepmann Well No. 1

Office Address 240 Sutton Place Wichita Kansas 67202

Character of Well (completed as Oil, Gas or Dry Hole) Dry hole

Date well completed 7/21 1976

Application for plugging filed 9/23 1976

Application for plugging approved 9/27 1976


Plugging commenced 9/27 1976

Plugging completed 10/1 1976

Reason for abandonment of well or producing formation Dry hole

If a producing well is abandoned, date of last production 19

Was permission obtained from the Conservation Division or its agents before plugging was commenced? yes

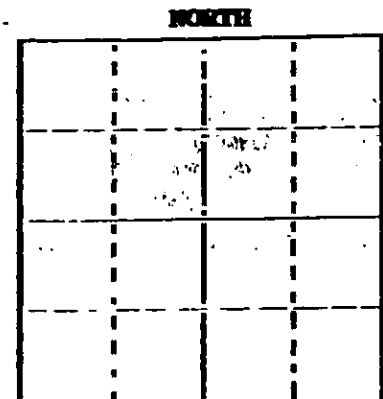

Locate well correctly on above Section Plot

Name of Conservation Agent who supervised plugging of this well Gilbert Toman

Producing formation Arb. Depth to top 3273 Bottom 3300 Total Depth of Well 3340

Show depth and thickness of all water, oil and gas formations.

OIL, GAS OR WATER RECORDS

CASING RECORD

FORMATION	CONTENT	FROM	TO	THICK	PER IN	PERFO DIST
	Surface	0	228	8 5/8		
		0	3274	5 1/2		2166

Describe in detail the manner in which the well was plugged, indicating where the mud fluid was placed and the method or methods used in introducing it into the hole. If cement or other plugs were used, state the character of same and depth placed, from feet to feet for each plug set.

filled with sand to 3250 and dumped 4 sx. cement

Squeezed top with Allied Cementers, pumped in 5 sx hulls
25 sx jell and 100 sx common cement under 600 lbs.

RECEIVED
STATE CORPORATION COMMISSION

OCT 05 1976

Name of Plugging Contractor Nicholas Casing Pulling

Address Box 273 Geneseo Kansas 67444

CONSERVATION DIVISION
Wichita, Kansas

STATE OF _____ COUNTY OF _____


(employee of owner) or (owner or operator) of the above-described well, being first duly sworn on oath, says: That I have knowledge of the facts, statements, and matters herein contained and the log of the above-described well as filed and that the same are true and correct. So help me God.

(Signature) George N. Nicholas

(Address)

this 4th day of October 1976

Glenn M. Stegman
Notary Public

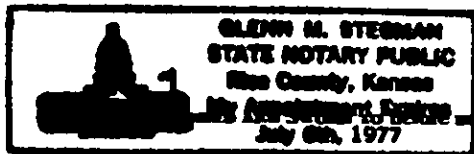

My commission expires 7-6-77

15-053-20446-00-00

July 23, 1976

DRILLERS LOG

#1 Schepmann
SW SE NW
Sec. 20-178-10W
Ellsworth County, Kansas

OPERATOR: Jayhawk Oil Company
CONTRACTOR: B & B Drilling, Inc.
COMMENCED: July 17, 1976
COMPLETED: July 21, 1976

8 5/8" @ 228' w/150 ex

0	228	Shale, Shells & Sand	
228	2560	Shale	
2560	2732	Shale & Lime	
2732	2890	Shale	
2890	3043	Shale & Lime	
3043	3275	Lime	
3275		RTD	5 1/2" @ 3274' w/75 ex

We certify that the above and foregoing is a true and correct copy of the log on the #1 Schepmann located in Ellsworth County, Kansas.

B & B DRILLING, INC.

Bill Lehar

Bill Lehar

Subscribed and sworn to before me this 23rd day of July, 1976.

Betty M. Abbott

Betty M. Abbott Notary Public

