


WELL PLUGGING RECORD

Give All Information Completely
Make Required Affidavit
Mail or Deliver Report to:
Conservation Division
State Corporation Commission
800 Bittling Building
Wichita, Kansas

NORTH

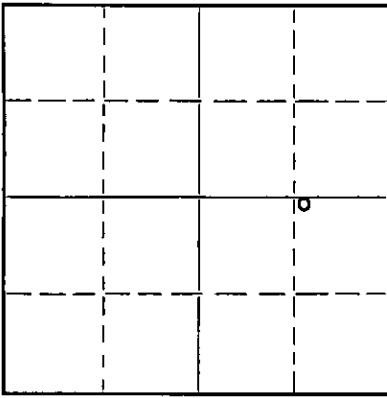

Locate well correctly on above
Section Plat

Stafford County. Sec. 21 Twp. 21S Rge. 14 (E) X (W)
Location as "NE/CNW $\frac{1}{4}$ SW $\frac{1}{4}$ " or footage from lines NW NE SE
Lease Owner J. D. Ferrell Drilling Co., Inc.
Lease Name Hedsoc Well No. 1
Office Address 1816 Broadway, Great Bend, Kansas
Character of Well (completed as Oil, Gas or Dry Hole) dry hole
Date well completed 1/11/52 19
Application for plugging filed 1/11/52 19
Application for plugging approved 1/11/52 19
Plugging commenced 1/11/52 19
Plugging completed 1/11/52 19
Reason for abandonment of well or producing formation no shows
If a producing well is abandoned, date of last production 19
Was permission obtained from the Conservation Division or its agents before plugging was commenced? yes

Name of Conservation Agent who supervised plugging of this well C. D. Stough
Producing formation -- Depth to top Bottom Total Depth of Well 3810 Feet
Show depth and thickness of all water, oil and gas formations.

OIL, GAS OR WATER RECORDS

CASING RECORD

Formation	Content	From	To	Size	Put In	Pulled Out
				8 5/8"	253'	not pulled cemented with 200 sacks bulk cement; circulated to surface.

Describe in detail the manner in which the well was plugged, indicating where the mud fluid was placed and the method or methods used in introducing it into the hole. If cement or other plugs were used, state the character of same and depth placed, from feet to feet for each plug set.

Filled hole with 11# mud; set Halliburton wood plug with 1/2 sack hulls and 15 sacks cement at 250'. Finished filling hole to 30' from base of cellar; set Halliburton wood plug with 1/2 sack hulls and 10 sacks cement.

1-16-52
JAN 16 1952

(If additional description is necessary, use BACK of this sheet)

Correspondence regarding this well should be addressed to P. O. Box 163, Great Bend, Kansas
Address J. D. Ferrell Drilling Co., Inc.

STATE OF Kansas, COUNTY OF Barton, ss.
G. J. Tooley (employee of owner) or (owner or operator) of the above-described well,
being first duly sworn on oath, says: That I have knowledge of the facts, statements, and matters herein contained and the log of the above-described well as filed and that the same are true and correct. So help me God.

(Signature) *G. J. Tooley*
P. O. Box 163, Great Bend, Kansas
(Address)

SUBSCRIBED AND SWORN to before me this 15th day of January, 1952

Emma Jean Sayre
Notary Public.

My commission expires August 29, 1955

PLUGGING
MLL SEC 21 T 21 R 14W
BOOK PAGE 137 LINE 11

15-185-00072-0000

WELL LOG

Petroleum Inc.
100 Derby Building
Wichita 2, Kansas

NW NE SE
Section 21-21S-14W
Stafford County, Kansas

Bledsoe #1

Total Depth: 3810'
Commenced: 12/29/51 Completed: 1/12/52
Contractor: J. D. Ferrell Drilling Co., Inc.
Rotary: 0 - 3810'

Casing Record: 257.04 of 8 5/8" surface casing @253' cemented with 200 sacks of bulk cement and 4 sacks of calcium chloride; cement circulated.

Formations

Cellar	0 - 4
Sand and Shale	4 - 40
Shale	40 - 90
Sand	90 - 215
Blue Shale	215 - 254
Shale	254 - 300
Sand	300 - 400
Red Bed	400 - 525
Sand and Red Bed	525 - 695
Shale and Lime	695 - 825
Shale and Shells	825 - 860
Anhydrite	860 - 890
Shale and Shells	890 - 1090
Shale	1090 - 1440
Shale and Shells	1440 - 1490
Lime and Shale	1490 - 1645
Shale and Shells	1645 - 1705
Broken Lime	1705 - 1785
Lime	1785 - 1985
Sandy Lime and Shale	1985 - 2015
Broken Lime	2015 - 2080
Lime	2080 - 2255
Lime and Shale	2255 - 2295
Shale and Shells	2295 - 2590
Lime and Shale	2590 - 2635
Broken Lime	2635 - 2695
Shale and Shells	2695 - 2830
Shale	2830 - 2940
Lime and Shale	2940 - 3020
Lime (Broken)	3020 - 3095
Brown Lime	3095 - 3155
Lime	3155 - 3293
Heebner Shale	3293 - 3298
Lime	3298 - 3305
Lime and Shale	3305 - 3410
Shale	3410 - 3411
Brown Lime	3411 - 3415
Shale	3415 - 3420
Lansing Lime	3420 - 3465
Lime	3465 - 3656
Shale	3656 - 3670
Lime	3670 - 3735
Shale	3735 - 3791
Arbuckle	3791 - 3810 T. D.

ST
JAN 16 1952
CO
Wichita, Kansas

Tops:

Heebner	3293
Lansing K. C.	3422
Base Kansas City	3656
Viola	3688
Simpson Shale	3735
Simpson Sand	3756
Arbuckle	3785

We certify this to be an accurate and correct log of the above described well as shown on the Daily Drilling Reports.

J. D. FERRELL DRILLING CO., INC.

PLUGGING
FILE SEC 21 T 21 R 14W
BOOK PAGE 37 LINE 11

J. T. Lenoir
J. T. Lenoir

Subscribed and sworn to before me this 15th day of January, 1952.

Emma Jean Lays
my comm. expires 8/29/52