


Give All Information Completely
Make Required Affidavit
Mail or Deliver Report to:
Conservation Division
State Corporation Commission
800 Bitting Building
Wichita, Kansas

15-051-04245-00-00
WELL PLUGGING RECORD

NORTH

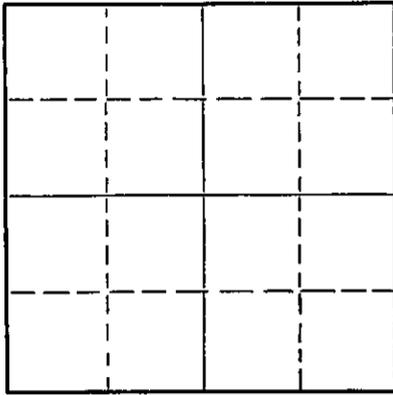

Locate well correctly on above
Section Plat

Ellis County, Sec. 2 Twp. 13 Rge. 18 (X) (W)
Location as "NE/CNWX/SW" or footage from lines NE NE SE
Lease Owner Doley Oil Company
Lease Name Rankin Well No. 1
Office Address Hays, Kansas
Character of Well (completed as Oil, Gas or Dry Hole) Dry Hole
Date well completed July 9 1954
Application for plugging filed July 9 1954
Application for plugging approved July 9 1954
Plugging commenced 7:00 P.M. July 9 1954
Plugging completed 9:30 P.M. July 9 1954
Reason for abandonment of well or producing formation Dry Hole

If a producing well is abandoned, date of last production 19
Was permission obtained from the Conservation Division or its agents before plugging was commenced? Yes, by telephone

Name of Conservation Agent who supervised plugging of this well Eldon Petty
Producing formation _____ Depth to top _____ Bottom _____ Total Depth of Well _____ Feet
Show depth and thickness of all water, oil and gas formations.

OIL, GAS OR WATER RECORDS				CASING RECORD		
FORMATION	CONTENT	FROM	TO	SIZE	PUT IN	PULLED OUT
				8 5/8"	160 ft.	None

Describe in detail the manner in which the well was plugged, indicating where the mud fluid was placed and the method or methods used in introducing it into the hole. If cement or other plugs were used, state the character of same and depth placed, from _____ feet to _____ feet for each plug set.

Hole filled with heavy rotary mud to 170 feet. First plug at 170 feet with 1/2 sack hulls and 15 sacks cement. Filled hole with heavy rotary mud from 170 feet to 40 feet. Second plug at 40 feet with 1/2 sack hulls and 10 sacks cement.

(If additional description is necessary, use BACK of this sheet)
Name of Plugging Contractor Kiefer & Krause drilling company, Inc.
Address Post Office Box 396, Great Bend, Kansas

STATE OF Kansas, COUNTY OF Barton, ss.
Richard B. Krause (employee of owner) or (owner or operator) of the above-described well, being first duly sworn on oath, says: That I have knowledge of the facts, statements, and matters herein contained and the log of the above-described well as filed and that the same are true and correct. So help me God.

(Signature) Richard B. Krause
Box 396, Great Bend, Kansas
(Address)

SUBSCRIBED AND SWORN TO before me this 25th day of August, 1954

My commission expires 4-11-55 Notary Public.

PLUGGING
FILE SEC. 2 T. 13 R. 18N
BOOK PAGE 58 LINE 15

DRILLERS LOG

COMPANY: DOLEY OIL COMPANY SEC: 2 T13S R18W
FARM: Rankin No. 1 LOC: NE NE SE
Ellis County, Kansas

TOTAL DEPTH: 3723'
COMM: 6-29-54 COMP: 7-9-54
CONTRACTOR: Kiefer & Krause Drilling Co., Inc.

CASING: 8 5/8" 160' ELEVATION: 2155' DF

15-051-04245-00-00
15-051-04245-00-00

- 0 110 Rock
- 110 130 Sand & Shale
- 130 870 Shale & Shells
- 870 1050 Sand
- 1050 1408 Shale & Shells
- 1408 1446 Anhydrite - Lime
- 1446 1525 Shale & Shells
- 1525 1700 Shale & Iron
- 1700 2015 Shale & Shells
- 2015 2165 Lime & Shale
- 2165 2330 Shale & Lime
- 2330 2720 Lime & Shale
- 2720 3035 Shale & Lime
- 3035 3115 Lime & Shale
- 3115 3565 Lime
- 3565 3615 Hard Lime
- 3615 3655 Lime
- 3655 3680 Lime & Shale
- 3680 3723 Lime

Cemented 8 5/8" Casing at 160 ft. with 135 sacks of cement.

3723 Total Rotary Depth. Plug 1 to 170 ft.; ran 15 sacks cement and 1/2 sack hulls. Plug 2 to 40 ft.; ran 10 sacks cement and 1/2 sack hulls.

I certify that this is the true and correct copy of the above log, to the best of my knowledge.

STATE CORPORATION COMMISSION
AUG 26 1954
CONSERVATION DIVISION
Wichita, Kansas

Richard B. Krumm

Subscribed and sworn to before me this 25 day of August, 1954.

John W. [Signature]
Notary Public

My Commission Expires 4-11-55

PLUGGING
FLY SEC 2 T 13 R 18W
BOOK PAGE 48 LINE 15