

15-051-00699-00-00

STATE OF KANSAS
STATE CORPORATION COMMISSION

WELL PLUGGING RECORD


Give All Information Completely
Make Required Affidavit
Mail or Deliver Report to:
Conservation Division
State Corporation Commission
800 Bittling Building
Wichita, Kansas

OR

FORMATION PLUGGING RECORD

Strike out upper line
when reporting plug-
ging of formations.

Ellis County Sec. 2 Twp. 13 Rge. (E) 18 (W)
Location as "NE¼NW¼SW¼" or footage from lines NW SE NW
Lease Owner Doley Oil Company
Lease Name Shytts Well No. 1
Office Address Hays, Kansas
Character of Well (completed as Oil, Gas or Dry Hole)
Date well completed 11/22/49
Application for plugging filed 1/16/50
Application for plugging approved 1/16/50
Plugging commenced 1/17/50
Plugging completed 1/21/50
Reason for abandonment of well or producing formation dry hole

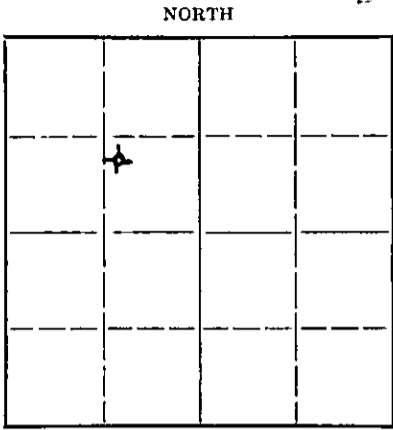

Locate well correctly on above
Section Plat

If a producing well is abandoned, date of last production 19
Was permission obtained from the Conservation Division or its agents before plugging was com-
menced? yes

Name of Conservation Agent who supervised plugging of this well E. Petty
Producing formation Depth to top Bottom Total Depth of Well 3688 Feet
Show depth and thickness of all water, oil and gas formations.

OIL, GAS OR WATER RECORDS

CASING RECORD

Formation	Content	From	To	Size	Put In	Pulled Out
Surface				8-5/8"	172'	cemented 135 sacks
Arbuckle Dolo.	water	3662	3688	5-1/2	3667	2817 ft.

Describe in detail the manner in which the well was plugged, indicating where the mud fluid was placed and the method or methods used in introducing it into the hole. If cement or other plugs were used, state the character of same and depth placed, from feet to feet for each plug set.

Hole plugged back to 3657 with cement & plastic. Dumped 10 ft. of chat 3657 to 3647 and overloaded hole with water and dumped 6 sacks of cement from 3647 to 3627'. Shot 5 1/2" casing at 2800'. Pulled casing and filled hole with heavy mud from pits. Placed bridge and 15 sacks of cement at 172' to 120'. Filled hole to 35' with mud and placed bridge at 35'. Filled hole with 10 sacks cement to bottom of cellar.

(If additional description is necessary, use BACK of this sheet)

Correspondence regarding this well should be addressed to Doley Oil Company
Address Hays, Kansas

STATE OF Kansas, COUNTY OF Ellis, ss.
I, E. DeWitt Doley (employee of owner) or (owner or operator) of the above-described well, being first duly sworn on oath, says: That I have knowledge of the facts, statements, and matters herein contained and the log of the above-described well as filed and that the same are true and correct. So help me God.

(Signature) E. DeWitt Doley
Hays, Kansas (Address)

SUBSCRIBED AND SWORN to before me this 2nd day of February, 1950.

My commission expires Aug 11, 1951
Lidwina Van Fleet Notary Public.

PLUGGING
FILE SEC 2 T13 R18W
BOOK PAGE 125 LINE 19

PLUGGING
FILE SEC 2 T13 R18W
BOOK PAGE 125 LINE 19

Company: Doley Oil Company
 Contractor: Glenn R. Nye Drilling Company
 Commenced: September 29, 1949
 Completed: October 11, 1949

Farm: Shutts No. 1
 Location: NW SE NW 2-13-18W
 Ellis County, Kansas
 Casing Record: 8 5/8" set at 165'

15-051-00699-00-00

(Figures below indicate bottoms)

surface soil	40
blue shale	165
blue shale	500
mixed shale red beds	790
shale & red bed	850
sand	1080
shale & sand	1120
shale & shells	1220
red bed & shale	1300
shale	1385
anhydrite	1405
anhydrite	1425
shale shell	1580
shale & shells	1700
shale sandy	1840
salt	1900
salt	1975
shale lime shells	2065
shale & lime shells	2190
shale & shells	2300
lime & shale	2320
lime shale-streaks	2410
lime & shale	2480
shale - lime	2530
shale lime	2655
shale & lime	2765
shale	2830
lime shale	2935
shale & lime	3025
shale - lime	3125
lime shale	
(some iron pyrite streaks)	3185
lime (hard)	3215
lime hard	3222
brown & blue shale	3238
lime	3265
lime	3295
lime - hard	3335
hard gray lime	3365
herbner shale	3368
lime	3380
lime hard	3420
lime - hard	3450
lime hard	3485
lime	3538
lime hard	3565
lime	3590
lime hard	3627
lime	3659 top Arb. 3655
	3661 T.D. Arb.

I hereby certify that this is a true and correct log of the above described well as shown by the drilling reports.

Glenn R. Nye Drilling Company

by Glenn R. Nye

State of Kansas }
 Ellis County } SS

PLUGGED
 WELL SEC 2-13-18W
 135 14

Subscribed and sworn to before me, a Notary Public, in and for Ellis County, Kansas, State this 8th day of December, 1949.

Kimberly A. Piat
 Notary Public

My Commission Expires, May 27, 1953