


STATE OF KANSAS
STATE CORPORATION COMMISSION

15-051-19392-00-02
15-051-19392-00-02
WELL PLUGGING RECORD

Give All Information Completely
Make Required Affidavit
Mail or Deliver Report to
Conservation Division
State Corporation Comm.
245 North Water
Wichita, KS 67202

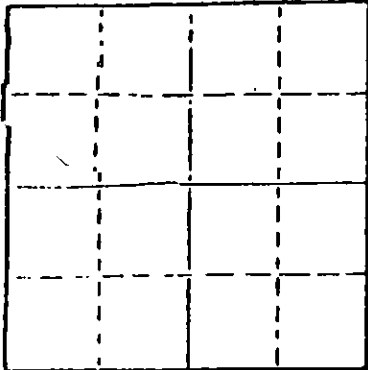

Locate well correctly on above
Section Plot

Ellis County. Sec. 2 Twp. 13S Rge. 18W E/W
Location as "NE/CNW $\frac{1}{4}$ SW $\frac{1}{4}$ " or footage from lines
SE NE NE
Lease Owner Gulf Oil Exploration & Production
Lease Name Crissman Well No. B-1-WI
Office Address R.R. 2 Box 96A Hoisington, Ks. 67544
Character of Well (Completed as Oil, Gas or Dry Hole)

Date Well completed 19
Application for plugging filed 19
Application for plugging approved 19
Plugging commenced 10-2-81 19
Plugging completed 10-6-81 19
Reason for abandonment of well or producing formation
Depleted
If a producing well is abandoned, date of last production 19

Was permission obtained from the Conservation Division or
its agents before plugging was commenced? Yes

Name of Conservation Agent who supervised plugging of this well Gilbert Scheck
Producing formation Depth to top Bottom Total Depth of Well 3636'
Show depth and thickness of all water, oil and gas formations.

OIL, GAS OR WATER RECORDS

CASING RECORD

FORMATION	CONTENT	FROM	TO	SIZE	PUT IN	PULLED OUT
				8-5/8"	1388'	none
				5-1/2"		2977'

Describe in detail the manner in which the well was plugged, indicating where the mud fluid
was placed and the method or methods used in introducing it into the hold. If cement or other
plugs were used, state the character of same and depth placed, from feet to
feet for each plug set.

Moved in on location, took stretch, set cast iron plug @3240' with 10 sacks cement.
Shot pipe @2992', pulled pipe to 1432', pumped 50 sacks common cement and displaced
with water. Pulled rest of casing, pumped 8 sacks gel, released plug, and 40 sacks
cement. Plugging Completed

(If additional description is necessary, use BACK of this sheet)

Name of Plugging Contractor Kelso Casing Pulling

STATE OF Kansas COUNTY OF Rice, ss.
R. Darrell Kelso (employee of owner) or (owner or operator)
of the above-described well, being first duly sworn on oath, says: That I have knowledge of
the facts, statements, and matters herein contained and the log of the above-described well
as filed and that the same are true and correct. So help me God.

(Signature) Chase, Kansas
(Address)

SUBSCRIBED AND SWORN TO before me this 15th day of October, 19 81

My commission expires



Notary Public.