


15-051-04308-00-00

Give All Information Completely  
Make Required Affidavit  
Mail or Deliver Report to:  
Conservation Division  
State Corporation Commission  
211 No. Broadway  
Wichita, Kansas

WELL PLUGGING RECORD

Ellis County, Sec. 20 Twp. 13S Rge. (E) 20W(W)

Location as "NE/CNW/SW" or footage from lines SE<sup>1</sup> SE<sup>1</sup> SW<sup>1</sup>  
Lease Owner Birmingham-Bartlett Drilling Co.  
Lease Name Flax Well No. 4  
Office Address 300 Kaufman Bldg., Wichita 2, Kansas  
Character of Well (completed as Oil, Gas or Dry Hole) ~~MINERAL~~ Dry Hole  
Date well completed Nov. 6, 19 62  
Application for plugging filed January 3, 19 63  
Application for plugging approved January 4, 19 63  
Plugging commenced January 26, 19 63  
Plugging completed January 28, 19 63  
Reason for abandonment of well or producing formation ~~MINERAL~~  
If a producing well is abandoned, date of last production 19  
Was permission obtained from the Conservation Division or its agents before plugging was commenced? Yes

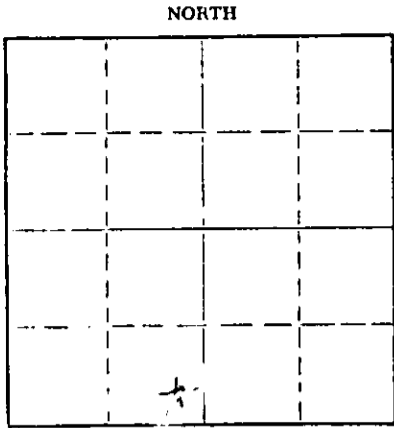

Locate well correctly on above Section Plat

Name of Conservation Agent who supervised plugging of this well Gilbert Leiker  
Producing formation Arbuckle Depth to top 3920 Bottom Total Depth of Well 3945 Feet  
Show depth and thickness of all water, oil and gas formations.

OIL, GAS OR WATER RECORDS

CASING RECORD

FORMATION	CONTENT	FROM	TO	SIZE	PUT IN	PULLED OUT
		0	206	8-5/8"	206'	None
		0	3923'	5-1/2"	3923'	2953'

Describe in detail the manner in which the well was plugged, indicating where the mud fluid was placed and the method or methods in introducing it into the hole. If cement or other plugs were used, state the character of same and depth placed, from feet for each plug set.

Sun cementing Co. Hays, Kansas  
Pumped 35 sacks of mud and 20 sacks of cement at 550' pulled pipe to 180'  
pumped 20 sacks of cement and run 10 sacks of cement from 30' to base of  
cellar.  
(Bottom of hole)  
Filled with sand from 3400' up to 3310', Then run 4 sacks of mixed cement  
filling 5 1/2" casing from 3310' up to 3286'; Shot pipe off at 2908'

FEB 5 1963  
15-051-1963

(If additional description is necessary, use BACK of this sheet)  
Name of Plugging Contractor GLENN & SMITH PIPE PULLING CO.  
Address ELLINWOOD, KANSAS

STATE OF KANSAS COUNTY OF SEDGWICK  
Chas. H. Keevert, Prod. Supt. of Birmingham-Bartlett Drilling Co.  
(employee of owner) or (owner or operator) of the above-described  
well, being first duly sworn on oath, says: That I have knowledge of the facts, statements, and matters herein contained and the log of the  
above-described well as filed and that the same are true and correct. So help me God.

(Signature) Chas. H. Keevert  
Wilson Rd., Rt. 1., Hutchinson, Kansas  
(Address)

SUBSCRIBED AND SWORN TO before me this 4th day of February 19 63

Vivian F. Yinger, Notary Public.

My commission expires November 29, 1966.

15-151-04308-00-00

FLAX NO. 4 WELL

LOCATION: SE/4 SE/4 SW/4  
Section 20-138-20W  
Ellis County, Kansas  
SPUDDED: 10-19-62  
COMPLETED: 10-30-62

OWNER, OPERATOR,  
and CONTRACTOR: Birmingham-Bartlett Drilling Co.  
300 Kaufman Bldg.  
Wichita 2, Kansas

SURFACE CASING: 8-5/8" used casing cemented  
at 206' with 150 sacks cement.

OIL STRING: 5-1/2" OD 14# H-40 and  
Republic X Tru-Coat H-40  
cemented at 3923' with  
175 sacks cement, 1 1/2 gal.

LOG

(Figures indicate bottom of formation)

0 -	40	Surface clay
	1105	Shale and shells
	1325	Sand
	1618	Shale and red bed
	1655	Anhydrite
	2135	Shale and shells
	2155	Shale
	3405	Shale and lime
	3525	Lime
	3590	Shale and lime
	3656	Lime
	3725	Shale and lime
	3785	Lime
	3880	Shale and lime
	3923	Lime and chert
	3928	Arbuckle
	3928	Rotary total depth

Nov 1 1962  
01-04-1963

The undersigned, Richard Hindery, one of the partners of Birmingham-Bartlett Drilling Co., hereby certifies that the above is a true and correct log of the formations encountered in drilling the Flax No. 4 Well as shown in the daily drilling reports.

BIRMINGHAM-BARTLETT DRILLING CO.

By Richard Hindery  
Richard Hindery, Partner

Subscribed and sworn to before me  
this 1st day of November, 1962.

Beverly Larson  
Beverly Larson, Notary Public  
My commission expires October 2, 1966.