


WELL PLUGGING RECORD

Give All Information Completely  
Make Required Affidavit  
Mail or Deliver Report to:  
Conservation Division  
State Corporation Commission  
212 North Market, Insurance Bldg.  
Wichita, Kansas

NORTH

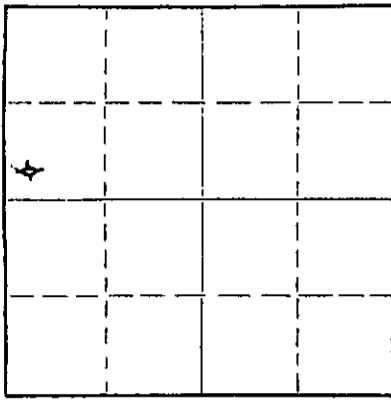

Locate well correctly on above  
Section Plat

Ellis County. Sec. 20 Twp. 13S Rge. 20 (E) W (W)  
Location as "NE/CNWxSWx" or footage from lines SW/4 SW/4 NW/4  
Lease Owner I. O. Miller  
Lease Name BITTLE Well No. 1  
Office Address 619 Brown Building, Wichita 2, Kansas  
Character of Well (completed as Oil, Gas or Dry Hole) Dry Hole  
Date well completed July 21, 19 60  
Application for plugging filed (Verbal) July 21, 19 60  
Application for plugging approved (Verbal) July 21, 19 60  
Plugging commenced July 21, 19 60  
Plugging completed July 21, 19 60  
Reason for abandonment of well or producing formation Dry Hole

If a producing well is abandoned, date of last production 19  
Was permission obtained from the Conservation Division or its agents before plugging was commenced? Yes

Name of Conservation Agent who supervised plugging of this well Eldon Petty  
Producing formation \_\_\_\_\_ Depth to top \_\_\_\_\_ Bottom \_\_\_\_\_ Total Depth of Well 3940 Feet  
Show depth and thickness of all water, oil and gas formations.

OIL, GAS OR WATER RECORDS

CASING RECORD

FORMATION	CONTENT	FROM	TO	SIZE	PUT IN	PULLED OUT
		0	207'	8-5/8	207'	none

Describe in detail the manner in which the well was plugged, indicating where the mud fluid was placed and the method or methods used in introducing it into the hole. If cement or other plugs were used, state the character of same and depth placed, from \_\_\_\_\_ feet to \_\_\_\_\_ feet for each plug set.

**Bottom plug set at 600' with 20 sacks cement mixed and poured through drill pipe. Middle plug set at 180' with 20 sacks cement. Top plug set at 40' with 10 sacks cement. Filled with mud to surface.**

**RECEIVED**  
STATE CORPORATION COMMISSION  
362  
09-11-1962  
CONSERVATION DIVISION  
Wichita, Kansas

(If additional description is necessary, use BACK of this sheet)  
Name of Plugging Contractor Birmingham-Bartlett Drilling Co.  
Address 300 Kaufman Bldg., Wichita 2, Kansas

STATE OF KANSAS COUNTY OF SEDWICK  
Richard Hindery, partner of Birmingham-Bartlett Drilling Co., contractor  
(employee of contractor) of the above-described well, being first duly sworn on oath, says: That I have knowledge of the facts, statements, and matters herein contained and the log of the above-described well as filed and that the same are true and correct. So help me God. **BIRMINGHAM-BARTLETT DRILLING CO.**  
(Signature) By Richard Hindery Partner  
300 Kaufman Building, Wichita 2, Kansas  
(Address)

SUBSCRIBED AND SWORN TO before me this 25th day of July, 19 60.

My commission expires October 2, 1962  
Beverly Larson  
Beverly Larson Notary Public.

BITTLE NO. 1 WELL

LOCATION: SW/4 SW/4 NW/4  
Section 20-13S-20W  
Ellis County, Kansas

SPUDDED: 7-12-60

COMPLETED: 7-21-60

OPERATOR: I. O. Miller  
619 Brown Building  
Wichita 2, Kansas

CONTRACTOR: Birmingham-Bartlett Drilling Co.  
300 Kaufman Building  
Wichita 2, Kansas

SURFACE CASING: 8-5/8" surface casing set at 207'  
with 190 ft. cement

OIL STRING: None set. Dry hole. Plugged  
on 7-21-60.

LOG

(Figures indicate bottom of formation)

0 -	90	Rock and clay
	140	Shale
	206	Shale and shells
	1280	Sand and shale
	1450	Red bed
	1566	Red bed and shale
	1610	Anhydrite
	2100	Shale and shells
	3300	Shale and lime
	3475	Lime
	3540	Lime and shale
	3661	Lime
	3726	Shale and lime
	3800	Lime
	3850	Lime and chert
	3900	Lime
	3940	Arbuckle
	3940	Rotary total depth

RECEIVED  
STATE CORPORATION COMMISSION  
SEP 11 1962  
09-11-1962  
CONSERVATION DIVISION  
Wichita, Kansas

The undersigned, Richard Hindery, one of the partners of Birmingham-Bartlett Drilling Co., hereby certifies that the above is a true and correct log of the formations encountered in drilling the Bittle No. 1 Well as shown in the daily drilling reports.

BIRMINGHAM-BARTLETT DRILLING CO.

By Richard Hindery  
Richard Hindery, Partner

Subscribed and sworn to before me  
this 25th day of July, 1960.

Beverly Larson  
Beverly Larson, Notary Public

My commission expires October 2, 1962.